


T.28S., R.6 W., W.M.

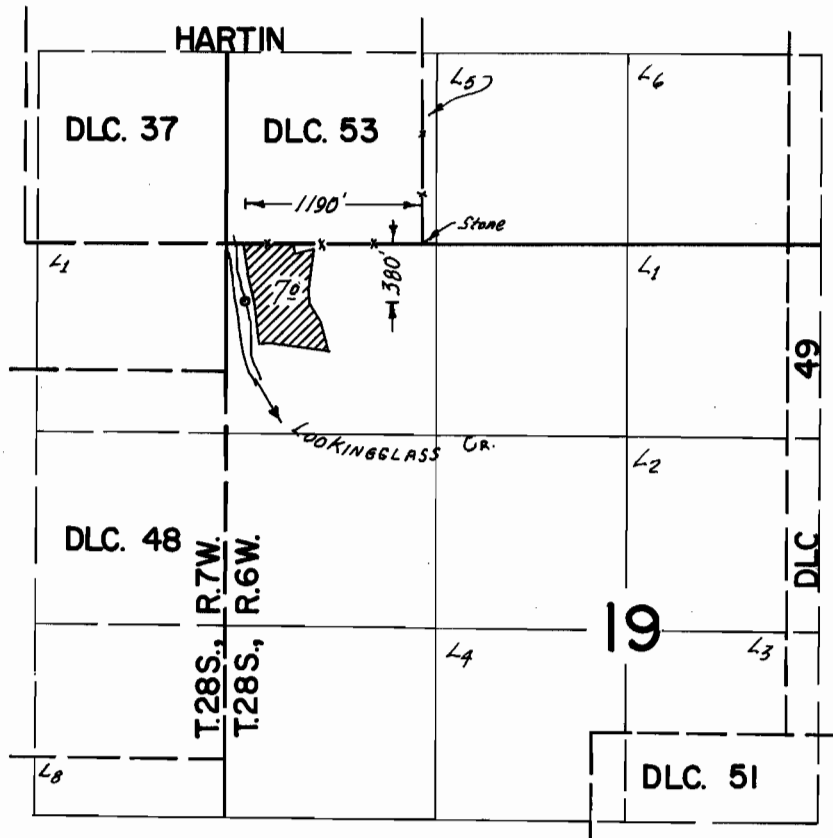

FINAL PROOF SURVEY UNDER

Application No. 44477 Permit No. 33267
IN NAME OF

WILLIS E. MALFAIT

Surveyed 11 MAY 19 72, by D. NORBY