


T.28S., R.6 W., W.M.

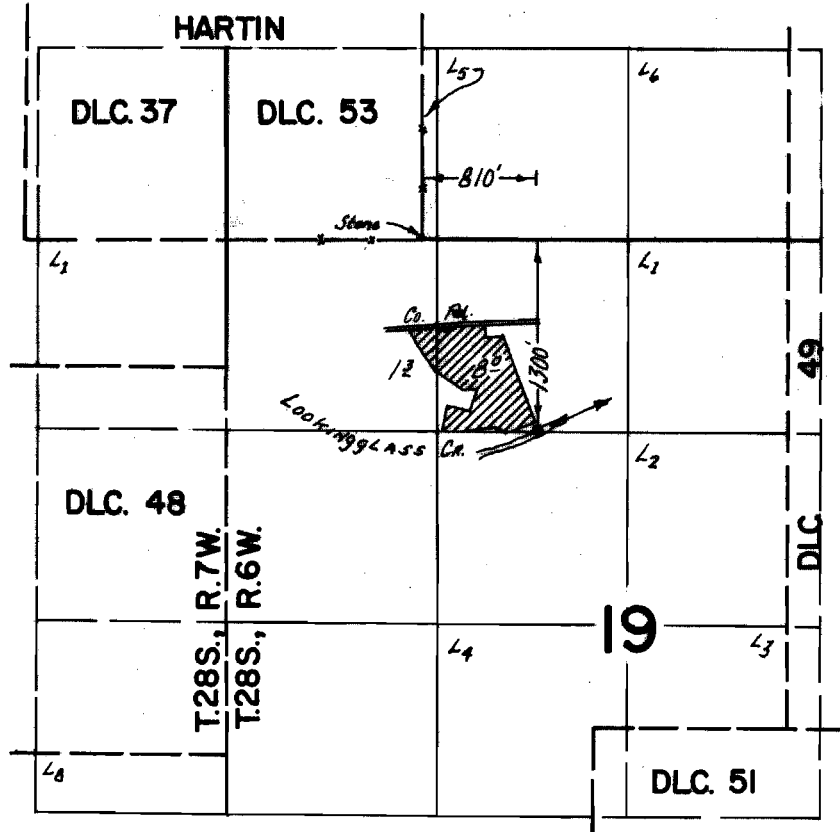

FINAL PROOF SURVEY UNDER

Application No. 44850 Permit No. 33489
IN NAME OF

DELBERT BAKER

Surveyed 4 MAY 1972, by D. NORBY