


T.22S., R.5W., W.M.

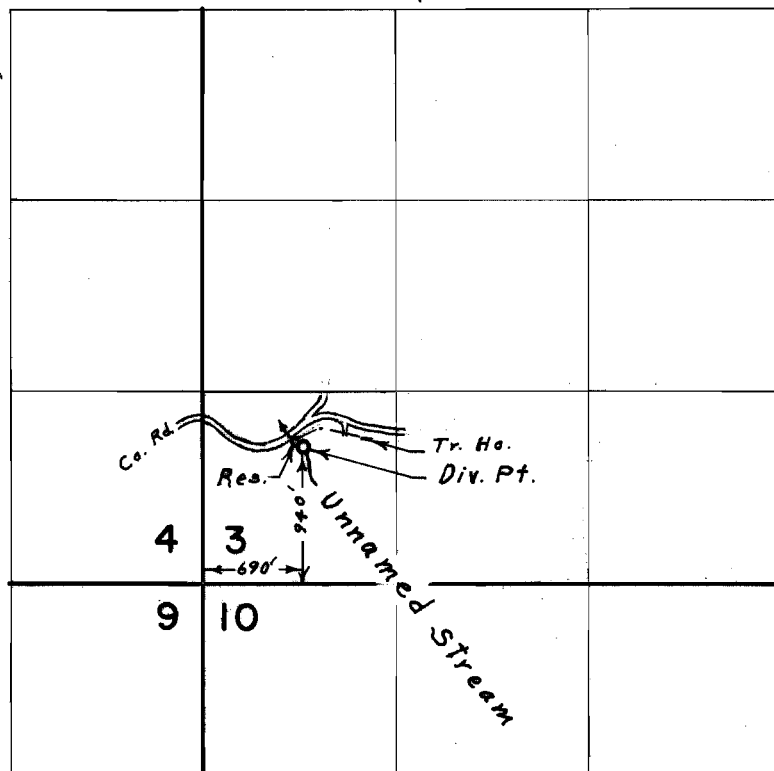

**FINAL PROOF SURVEY**  
UNDER

Application No. 45617 Permit No. 34027  
IN NAME OF

WALTER & LEONA TOLMAN

Surveyed May 12, 1972, by L. E. Gould