
## T. 30S., R.6 W., W.M.

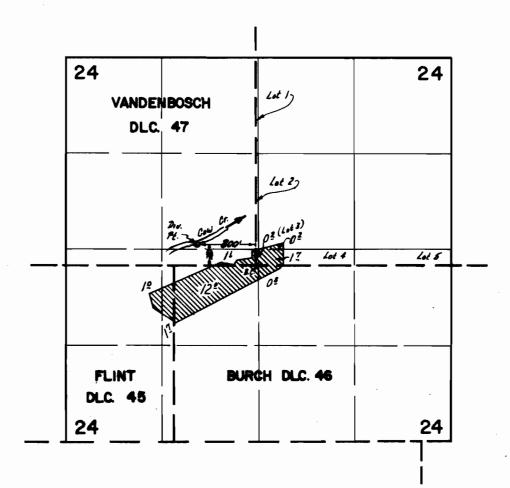

## FINAL PROOF SURVEY

Application No. 45849 Permit No. 34230 IN NAME OF		
ROBERT M. DORT		
Surveyed Sept. 13	19.72., byDNQI	RBY