


T.25 S., R.7 W., W.M.

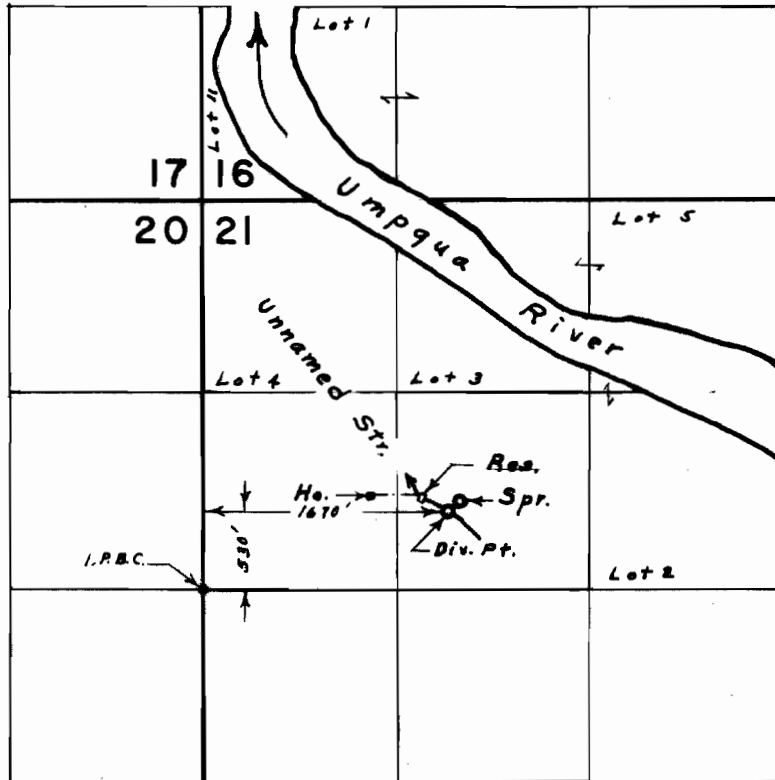

**FINAL PROOF SURVEY**  
UNDER

Application No. 46530 Permit No. 34763  
IN NAME OF

JAMES E. & MABLE A. CUSTER

Surveyed May 2, 1972, by L. E. Gould