


T.32 S., R.6 W., W.M.

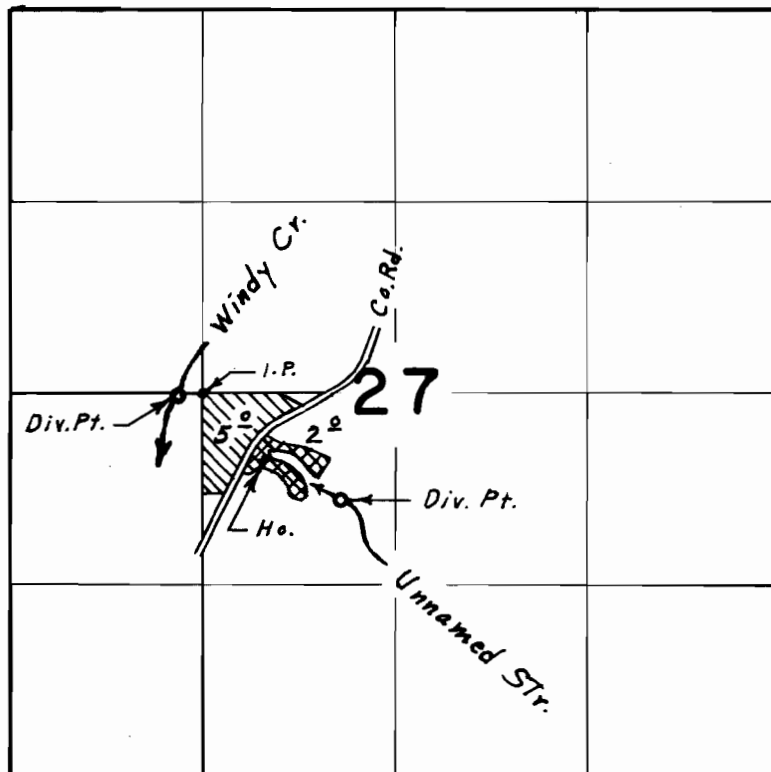

Div. Pts. located: Windy Cr., 30' S. & 160' W.; Unnamed Str., 730' S. & 950' E., both from N.W. Cor. NE. $\frac{1}{4}$ S.W. $\frac{1}{4}$ Sec. 27

Windy Creek
Unnamed Str.



FINAL PROOF SURVEY UNDER

Application No. 46069 Permit No. 34799
IN NAME OF

GLENN R. GILMORE

Surveyed Aug. 23, 1972, by L. E. Gould