


T.26S., R.6W., W.M.

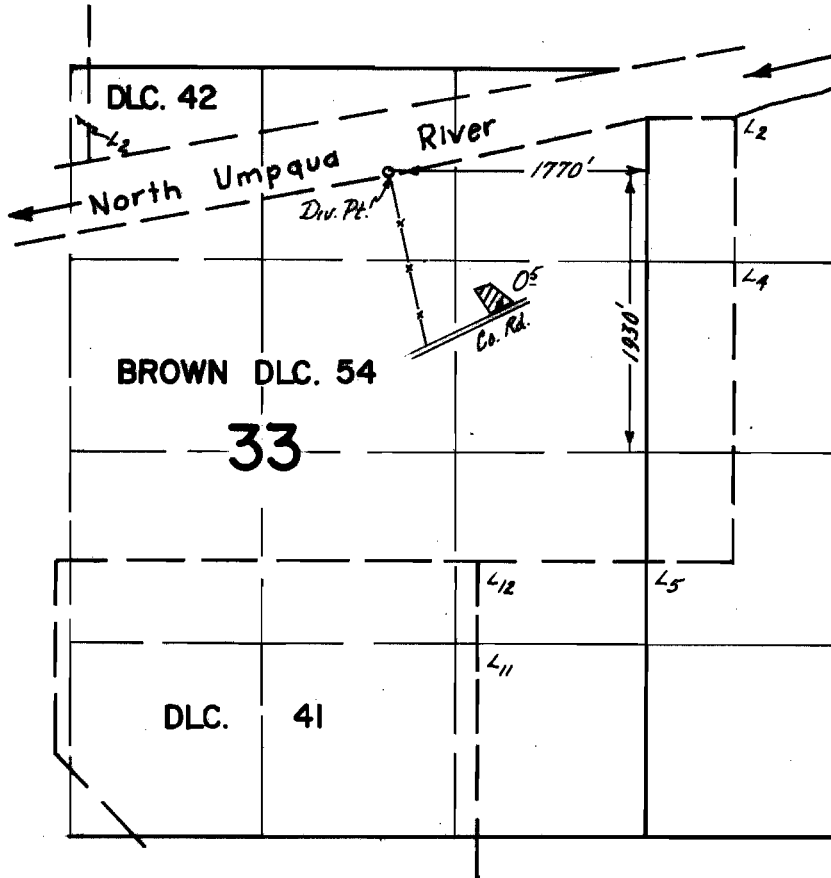

FINAL PROOF SURVEY UNDER

Application No. 46915 Permit No. 35098
IN NAME OF

EARL D. WILSON

Surveyed 2 Mar 1972, by D. NORBY