



P. 30449
39467 ORT

T.13S., R.34E., W.M.

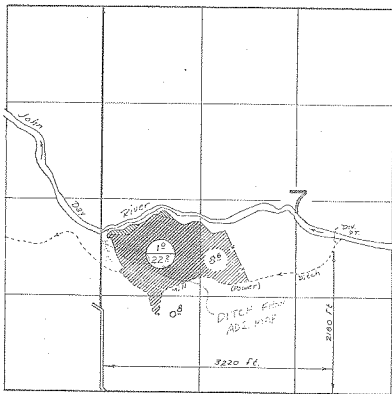

Note attached
see sheet for
further info.
3 sections
following

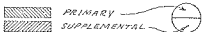

18 ac - APPROX. LAND SUPPL
TO COST 2536052591

APPROX. LAND ALREADY
OCCUPIED BY COST 25357
FROM JOHN DAY RIVER

1 ac - PRIMARY UNDER PERMIT
30449

FINAL PROOF SURVEY UNDER

Application No. 40708 Permit No. 30499
IN NAME OF

ERVING STANBRO

Surveyed Aug 3 1972, by D. Norby