


•

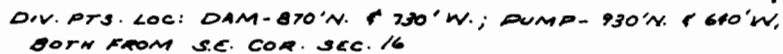

UNDER

R-44087

R-5103

IN NAME OF

Surveyed SEPT. 16, 1973, by R. MUCKEN