


T.3S.R.4E.W.M

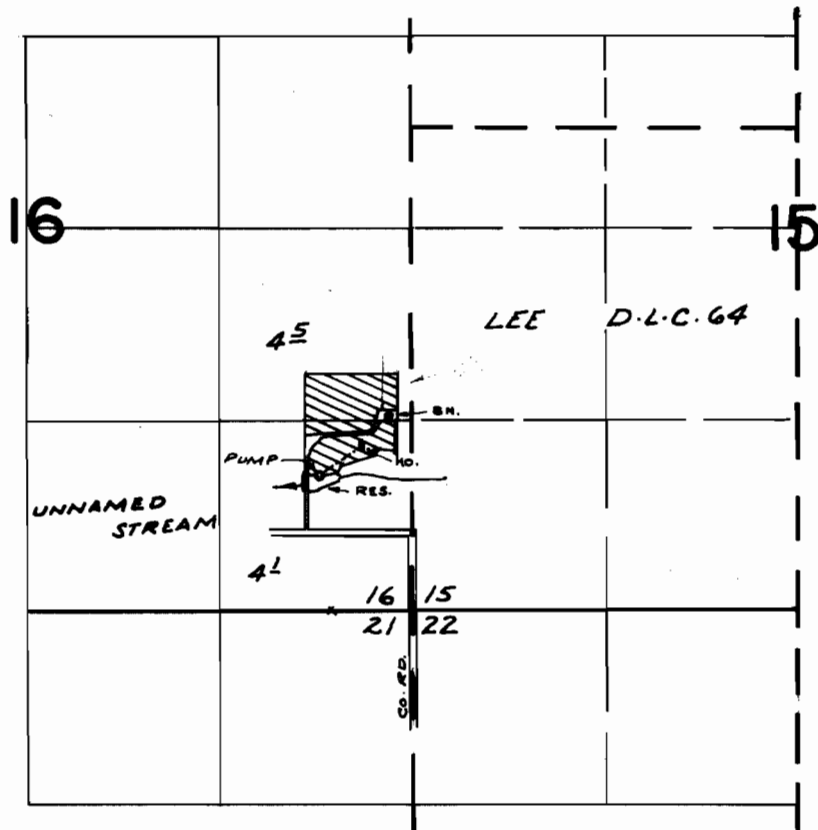

DIV. PTS. LOC: DAM-870'N. & 730'W.; PUMP-930'N. & 680'W,
BOTH FROM S.E. COR. SEC. 16

FINAL PROOF SURVEY
UNDER

Application No. R-44087 44224 Permit No. R-5103 33033
IN NAME OF

MELVIN G. WOLF & VIOLA M. WOLF

Surveyed SEPT. 16, 1973, by R. MUCKEN