


T.29S.R.12W.W.M.

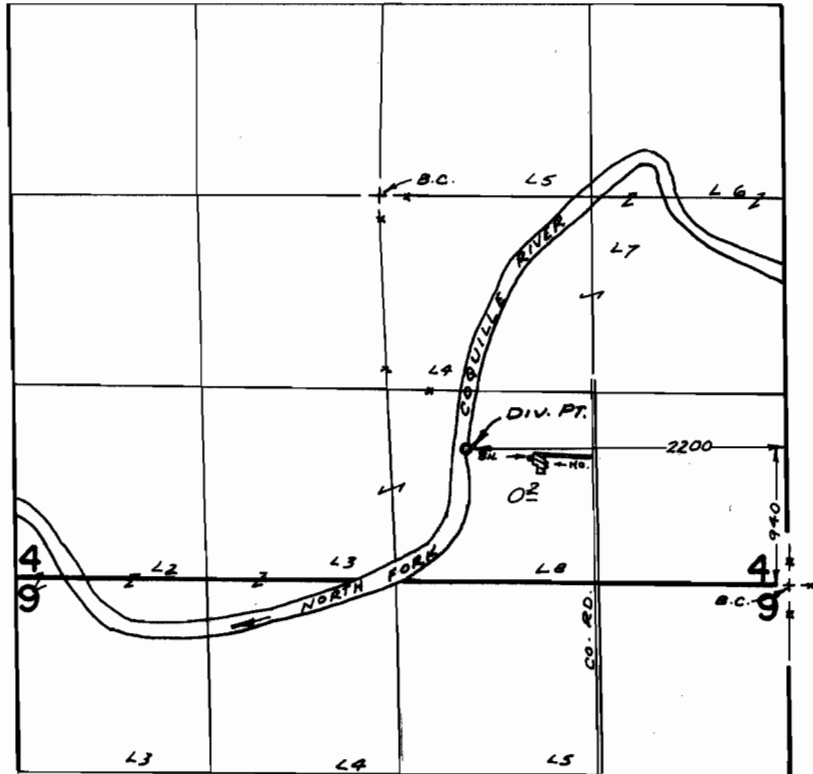

FINAL PROOF SURVEY
UNDER

Application No. 39699 Permit No. 29768
IN NAME OF

RICHARD A. & CAROL S. CAPEHART

Surveyed JULY 17, 1972, by R. MUCKEN