


# T.27S.R.5W.W.M.

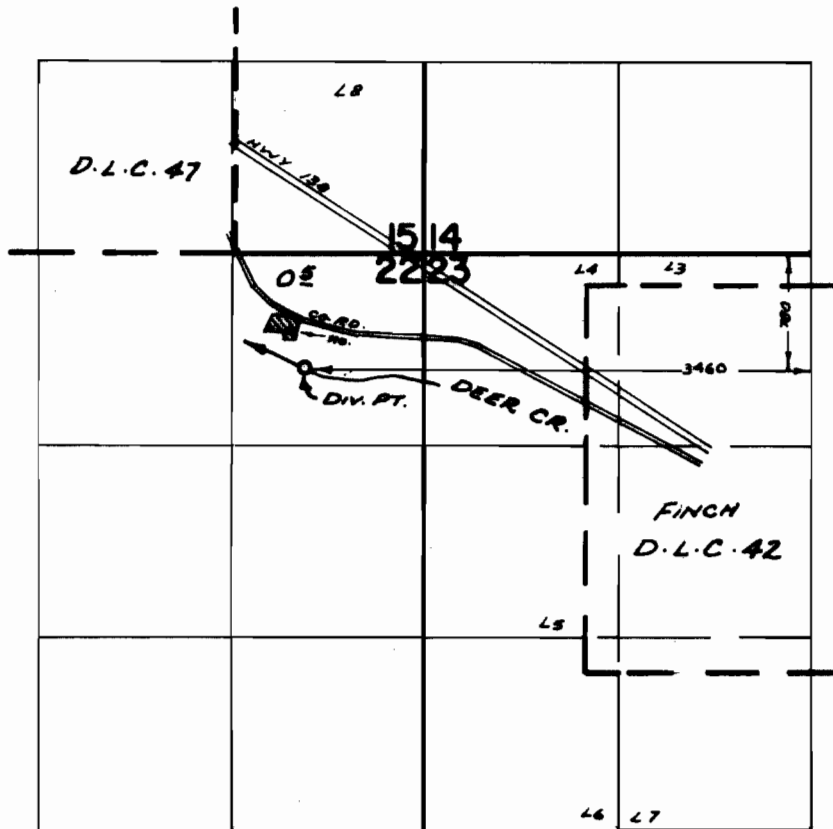

## FINAL PROOF SURVEY UNDER

Application No. 41315 Permit No. 30850  
IN NAME OF

JAMES BAKER

Surveyed MAY 1, 1972, by R. MUCKEN