


T. 24 S., R. 5 W., W.M.

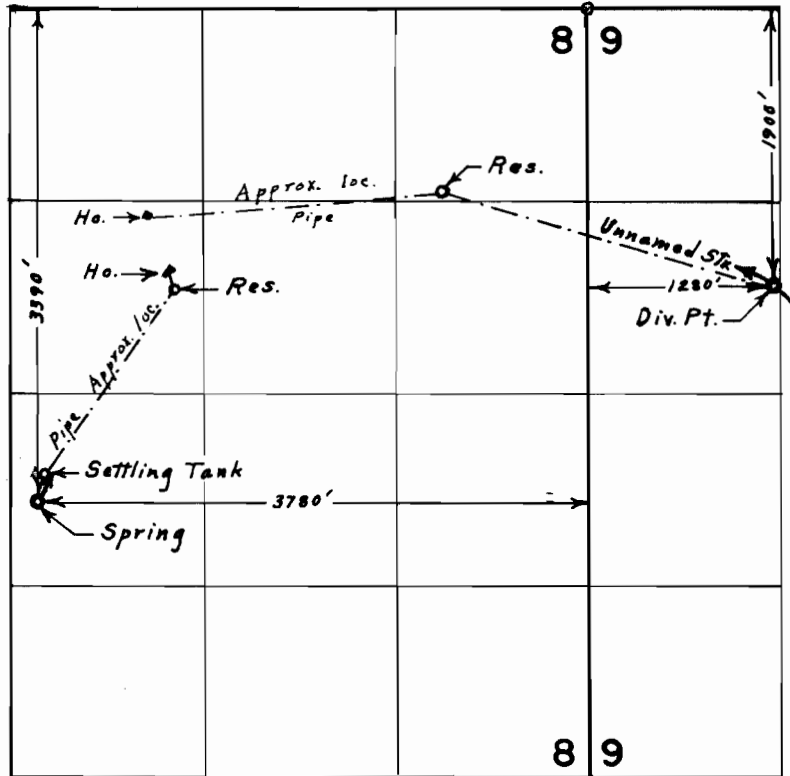

FINAL PROOF SURVEY
UNDER

Application No. 45155 Permit No. 33331
IN NAME OF

JAMES E. CLARK

Surveyed May 2, 1972, by L. E. Gould