


T. 30S., R. 5W., W.M.

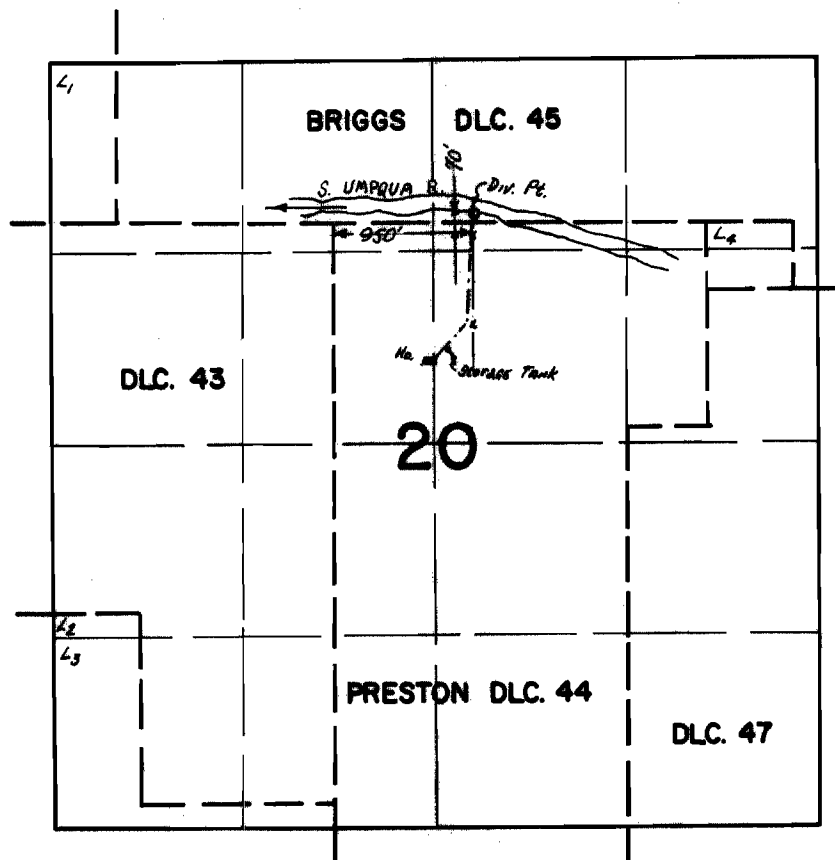

FINAL PROOF SURVEY UNDER

Application No. 44882 Permit No. 33557
IN NAME OF

RONALD SINGLER

Surveyed 15 Sept. 1972, by D. NORBY