T.29S.R.5W.W.M.

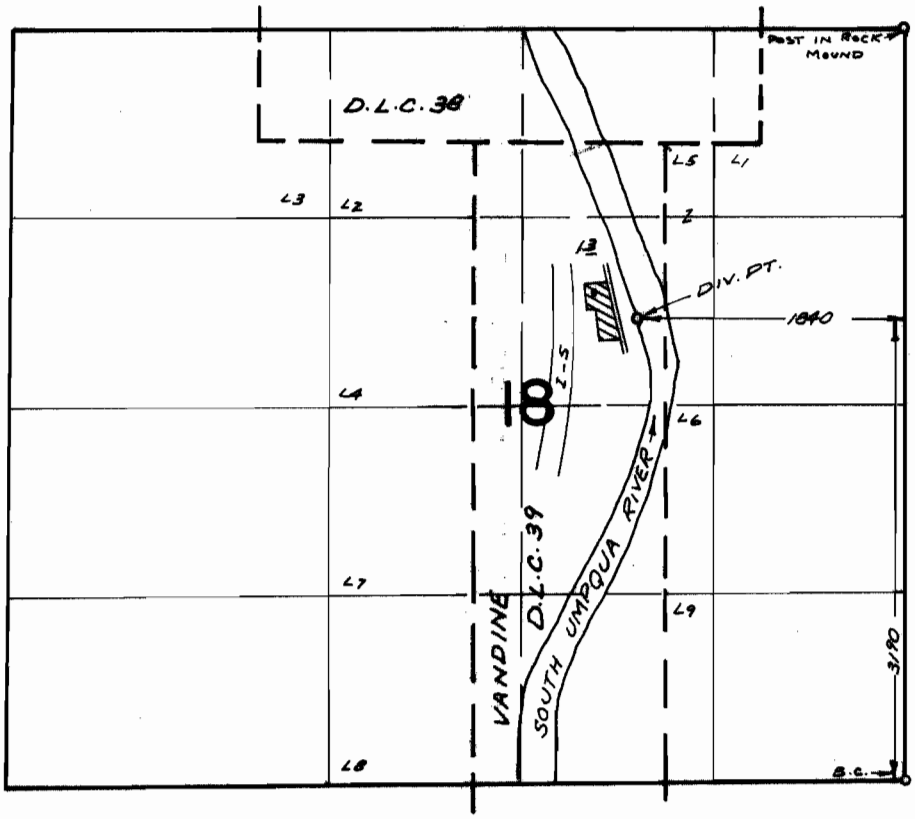

FINAL PROOF SURVEY
UNDER

Application No. 44888 Permit No. 33562
IN NAME OF

ERNEST M. & JOLENE L. VOSS

Surveyed MAY 8 1972, by R. MUGKEN

BTR-1HH-259