


# T.26S., R.6W., W.M.

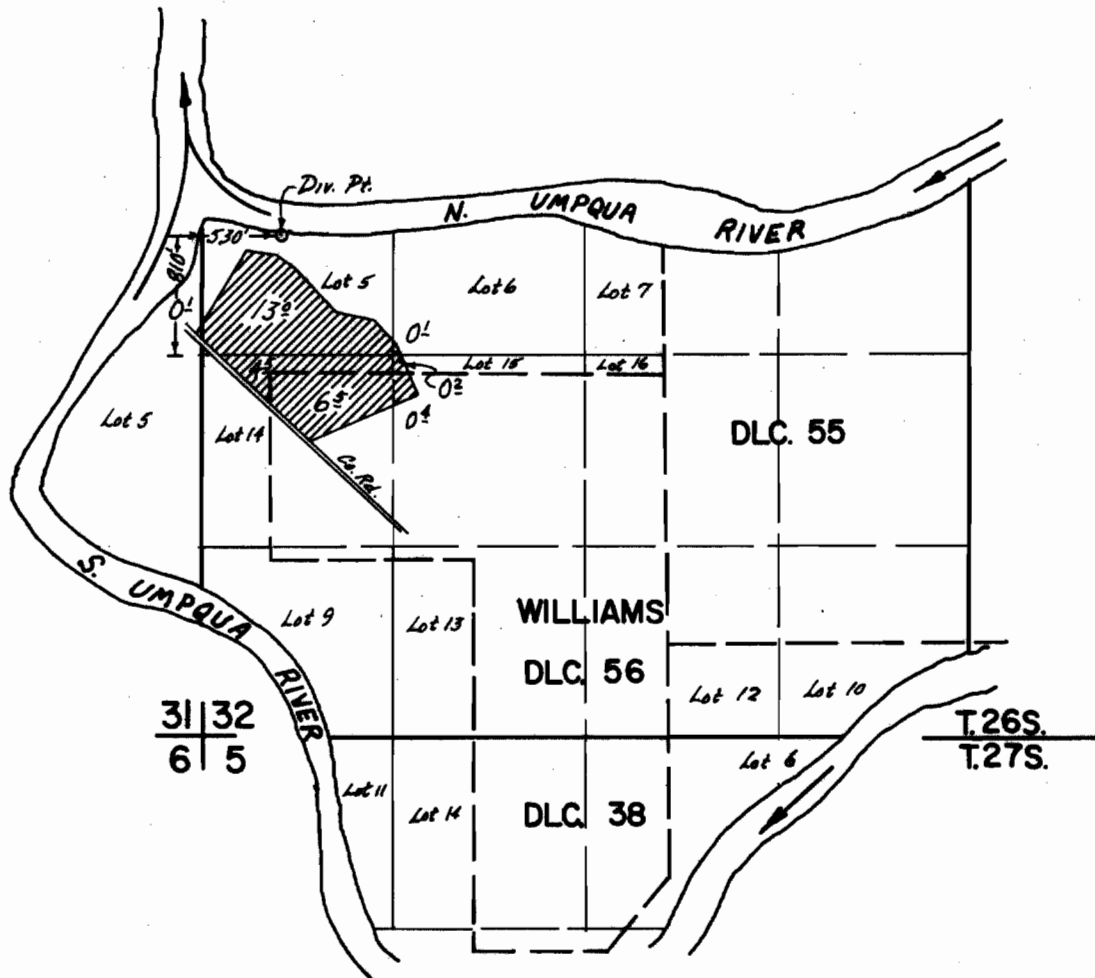

## FINAL PROOF SURVEY UNDER

Application No. 45709 Permit No. 34096  
IN NAME OF

ALVIN T. & MARY L. O'CONNOR

Surveyed 2 MAY 1972 by D. NORBY