


# T.27S.R.5 & 6 W.W.M.

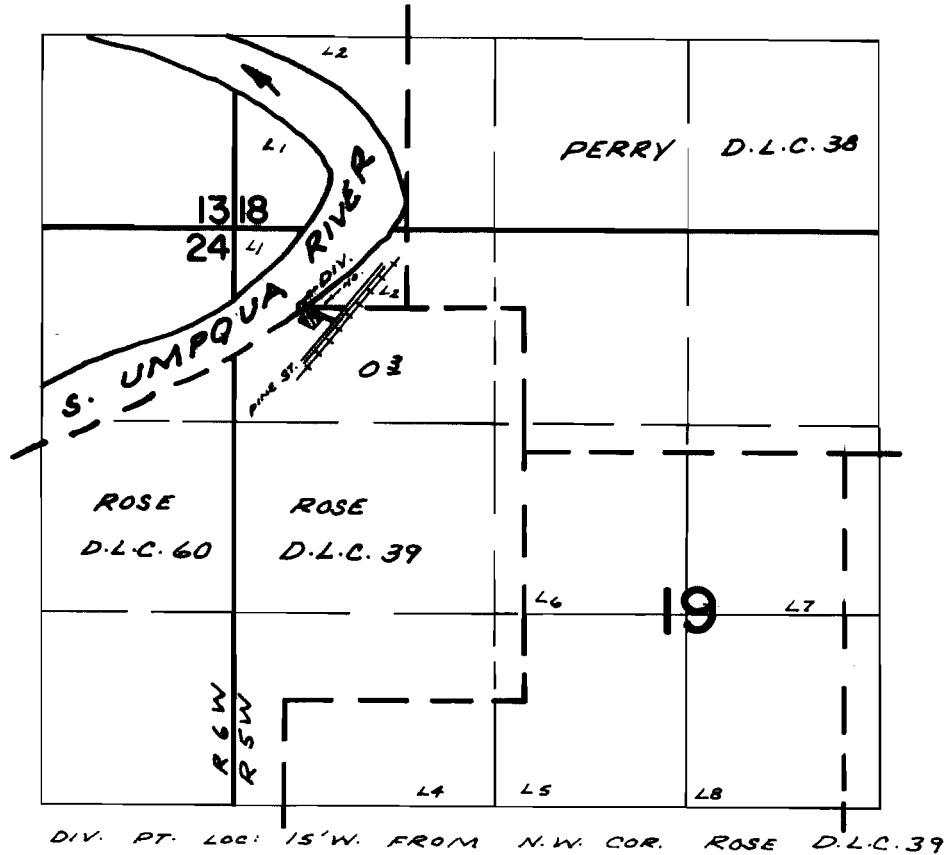

## FINAL PROOF SURVEY UNDER

Application No. 45997 Permit No. 22356  
IN NAME OF

CARL FAIR

Surveyed MAY 1, 1972, by R. MUCKEN