


T.27R.3W.W.M.

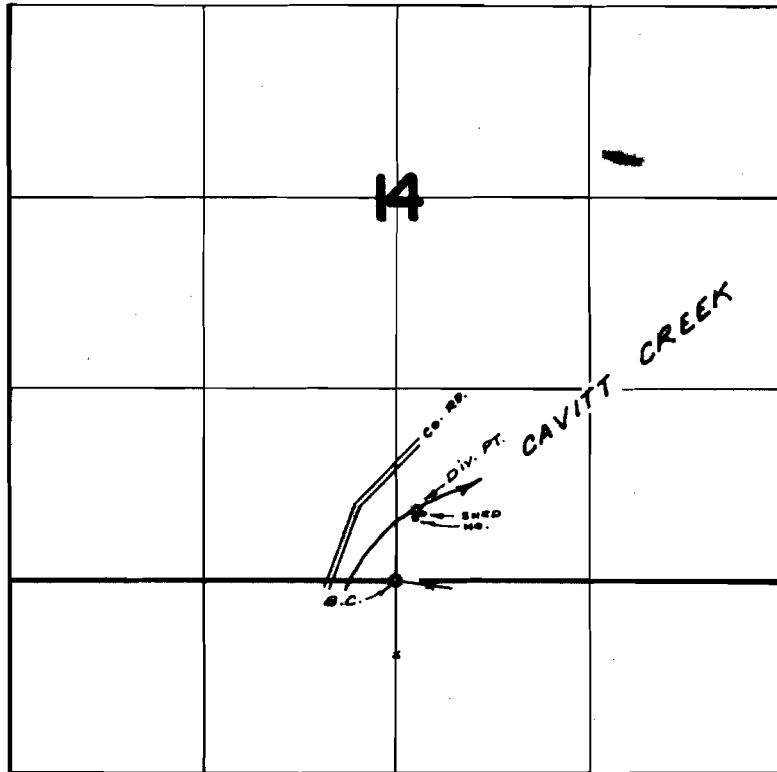

DIV. PT. LOC: 480' N. & 140' E. FROM S 1/2 COR. SEC. 14

**FINAL PROOF SURVEY**  
UNDER

Application No. 46399 Permit No. 34651  
IN NAME OF

BARTON D. FELDKAMP

Surveyed MAY 5, 1972, by R. MUCKEN