


T.33S.,R.7W.,W.M.

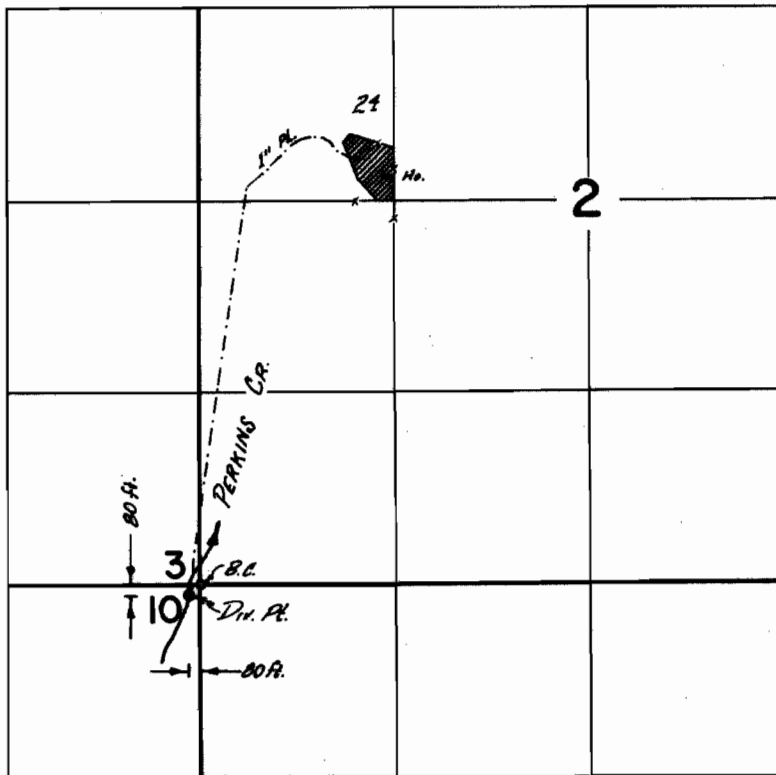

FINAL PROOF SURVEY
UNDER

Application No. 46868 Permit No. 35087
IN NAME OF

EMBY TROXELL

Surveyed 22 Aug. 1972, by L.E. GOULD