


T.13S., R.31E., W.M.

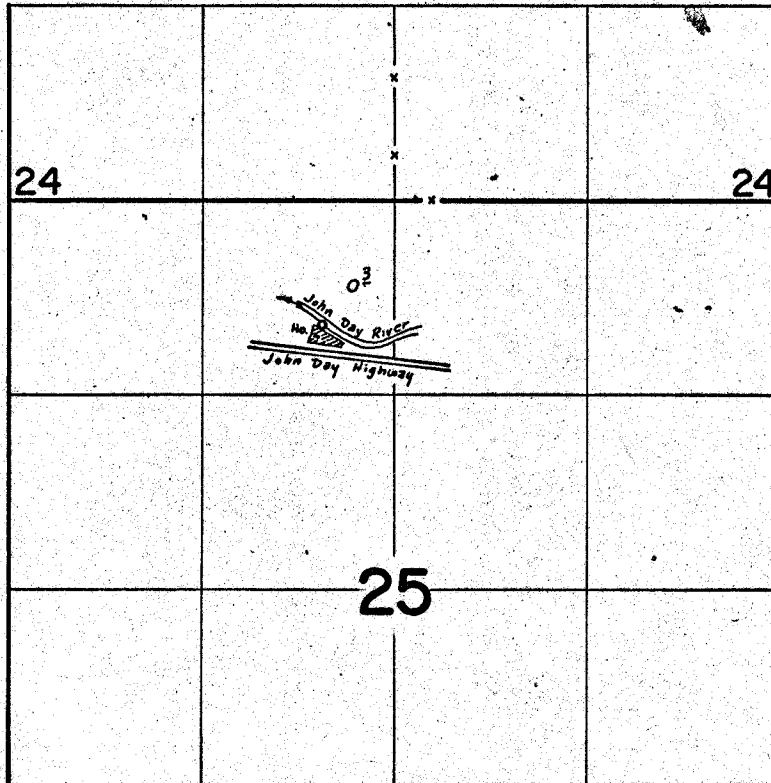

DIV. PT. LOCATED: 840' S & 490' W FROM N 1/4 COR. SEC. 25

FINAL PROOF SURVEY UNDER

Application No. 44409 Permit No. 33172
IN NAME OF
THOMAS P. & BILLIE JO RYAN

Surveyed July 11 1972, by D. Norby