


T.13S., R.31E., W.M.

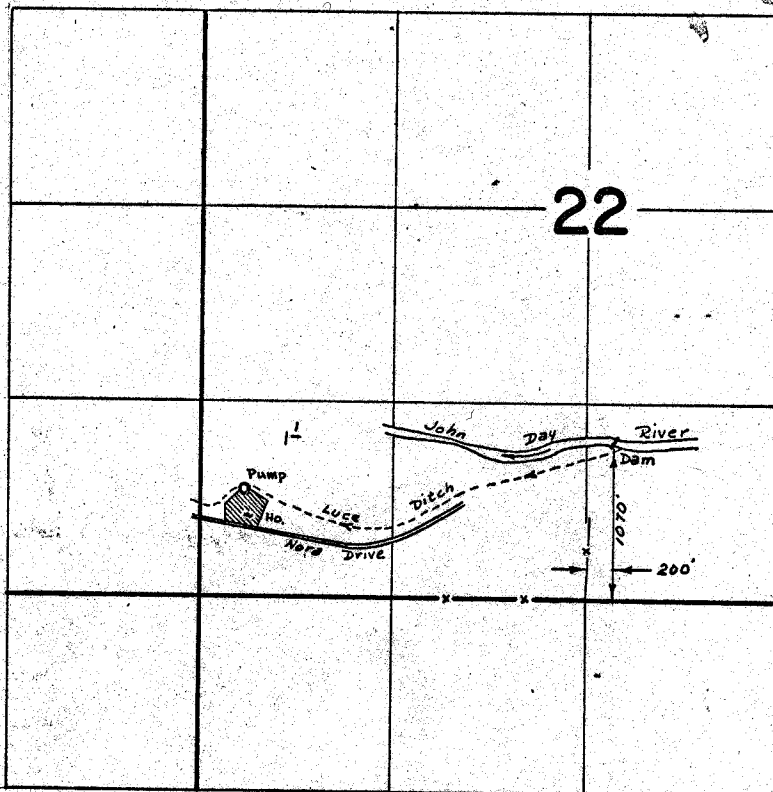

FINAL PROOF SURVEY UNDER

Application No. 44680 Permit No. 33451

IN NAME OF

BILL HICKERSON

Surveyed July 11 19 72, by D. Norby