


T.13S., R.31E., W.M.

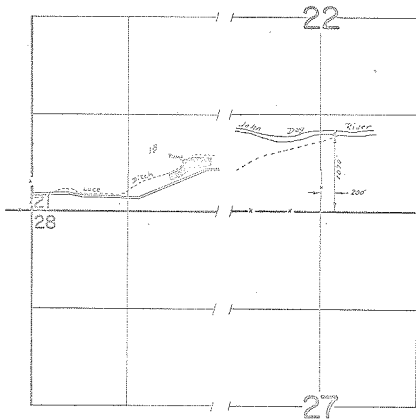

FINAL PROOF SURVEY  
UNDER

Application No. 46013 Permit No. 34368  
IN NAME OF

EUGENE A. NEGUS and/or CORA B. NEGUS

Surveyed July 12 1972 by D. Norby