


T.37S.R.IE.W.M.

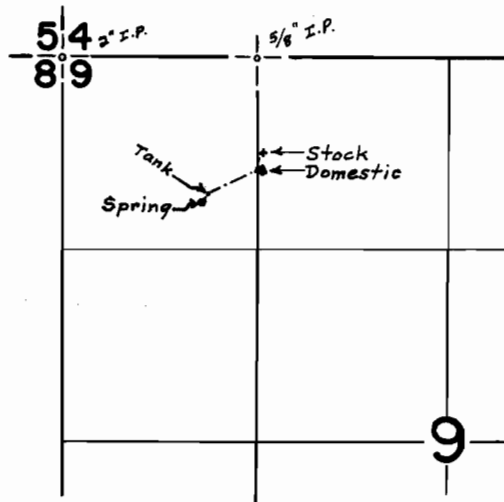

Spring is located 995'S. &
960'E. from N.W. Cor. Sec. 9.

FINAL PROOF SURVEY UNDER

Application No. 42934 Permit No. 32078
IN NAME OF

Lester H. & Mabel M. Wertz

Surveyed Jan. 4 1974, by D.C. Hendrix