


T.33S.R.5W.W.M.

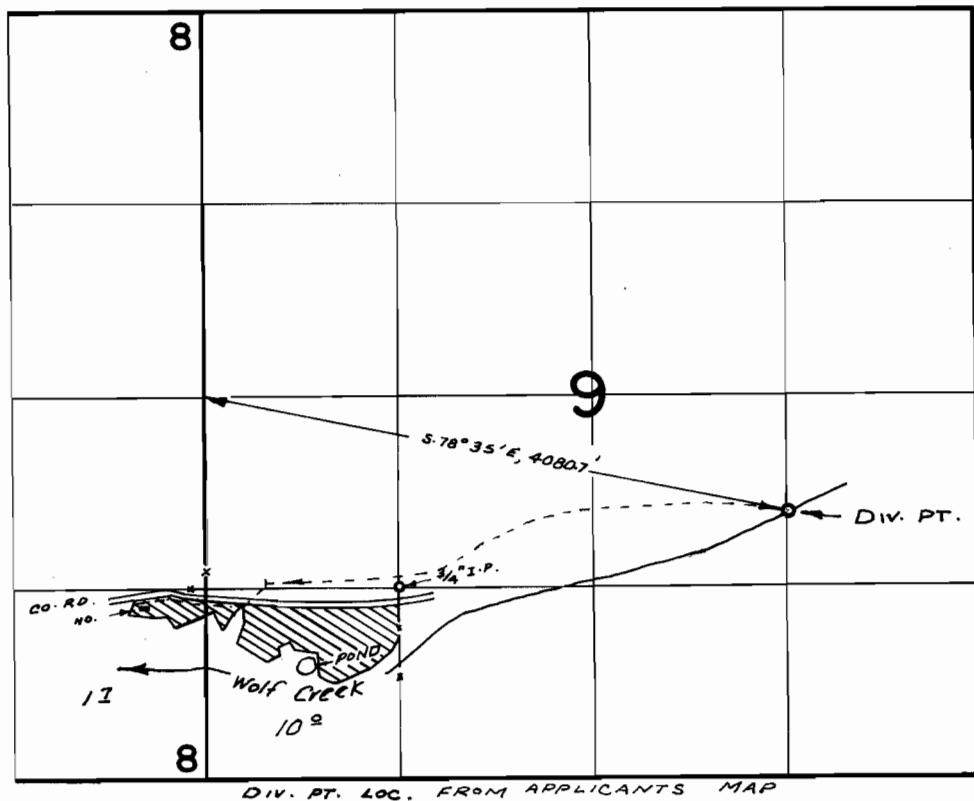

FINAL PROOF SURVEY
UNDER

Application No. 44654 Permit No. 33434
IN NAME OF

OVE S. R. BECK

Surveyed APR. 13, 1972, by R. MUCKEN