


T.33S.R.7W.W.M.

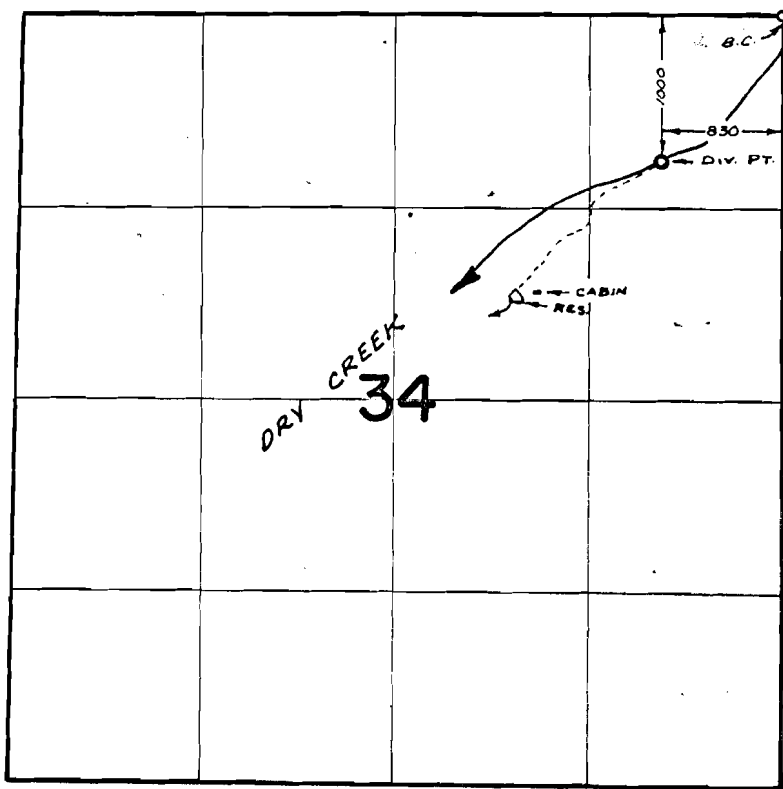

**FINAL PROOF SURVEY**  
UNDER

Application No. *R-41856* *41341* Permit No. *R-4670* *30987*  
IN NAME OF

.....*ROBERT E. LONG*.....

Surveyed *APR. 13, 1972*, by *R. MUGKEN*