


T. 33S. R. 7W. W.M.

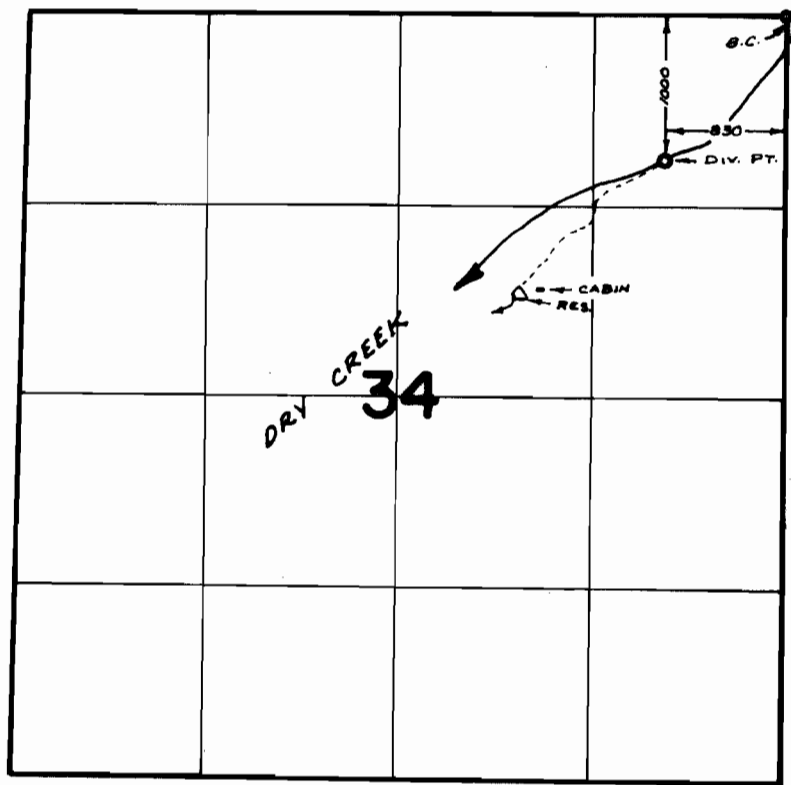

FINAL PROOF SURVEY UNDER

Application No. ^{R-41856} 41341 Permit No. ^{R-4670} 30997
IN NAME OF

ROBERT E. LONG

Surveyed APR. 13, 1972, by R. MUGGEN