


T. 11 S., R. 2 W., W.M.

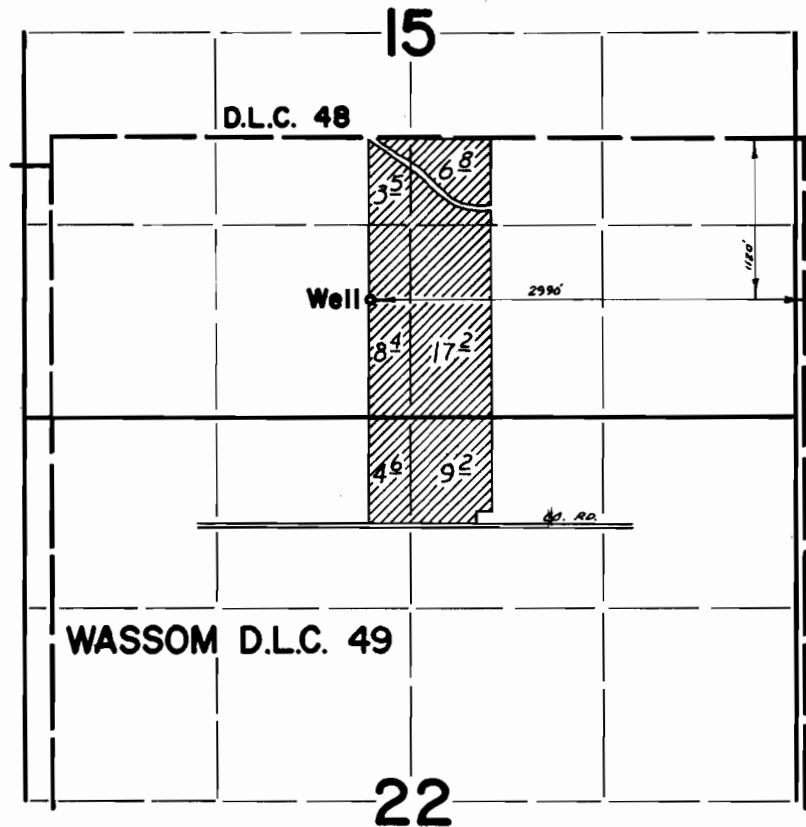

FINAL PROOF SURVEY
UNDER

Application No. G-3771 Permit No. G-3557
IN NAME OF

ROBERT F. AND ISABEL R. MEYER

Surveyed June 18 1973, by D. Norby