


# T.10S.R2W.W.M.

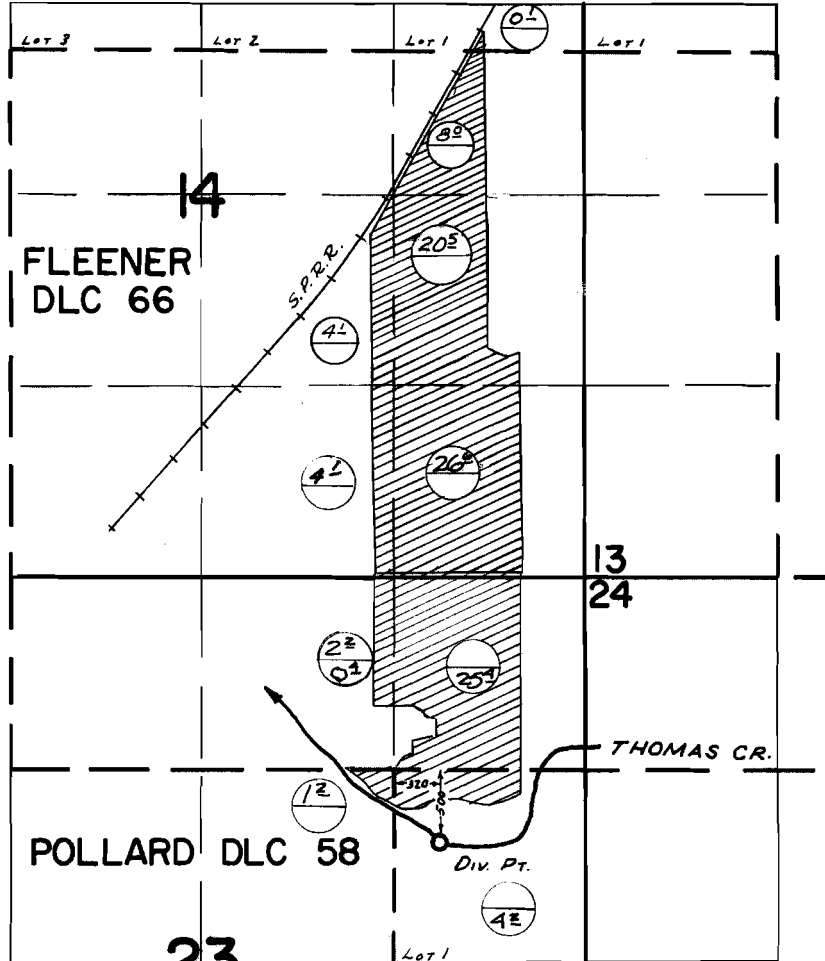

## 23 FINAL PROOF SURVEY UNDER

Permit 29714  
Cert 21413

Application No. 39921 Permit No. 29714  
IN NAME OF

**JAMES & ANITA COLCORD**

Surveyed MARCH 17, 1969, by W. RUPPERT  
Sept 5, 1972 D. Norby