


# T.5S. R.1W. W.M.

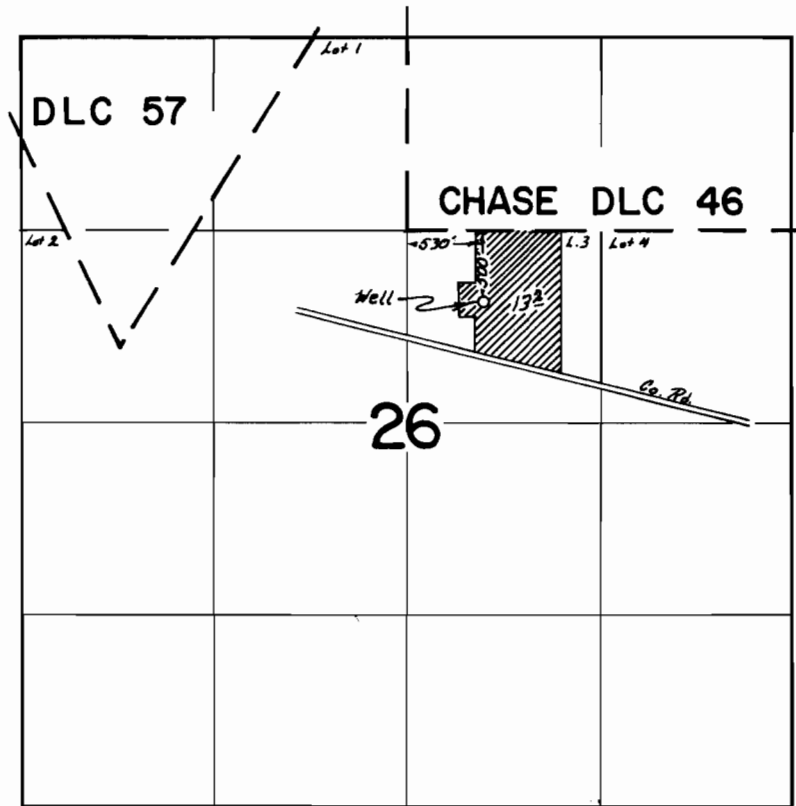

## FINAL PROOF SURVEY UNDER

Application No. B-3580 Permit No. B-3371  
IN NAME OF

EDWIN C. BARCHENGER

Surveyed Aug 18 1971, by R. B. MUCKER?