


T.5S. R.2W., W.M.

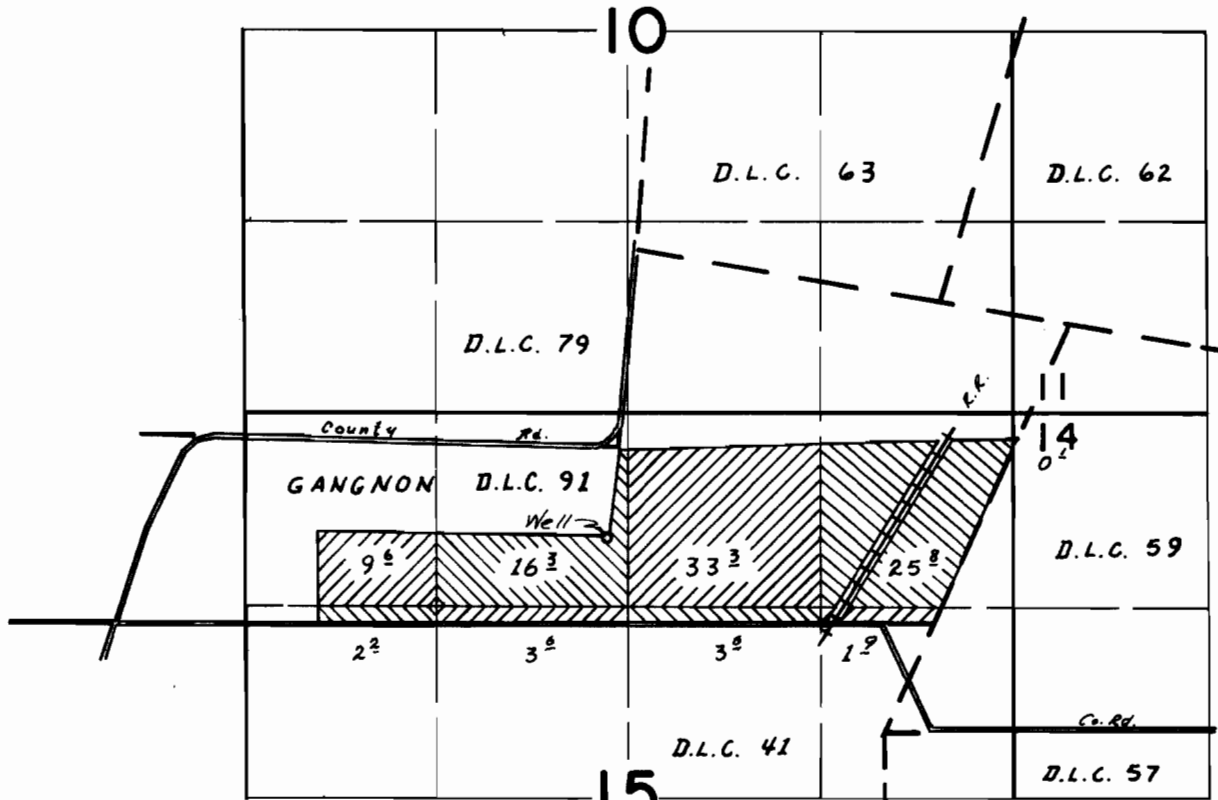

Well loc. 600' N. & 2250' W. from S.E. cor. GANGNON D.L.C. 91

FINAL PROOF SURVEY UNDER

Application No. G-3615. Permit No. G-3398
IN NAME OF

Leonard Ferschweiler

Surveyed 9 OCT 1972, by *D. O'Reilly*