


T. 4, 5 S. R. 1, 2 W. W.M.

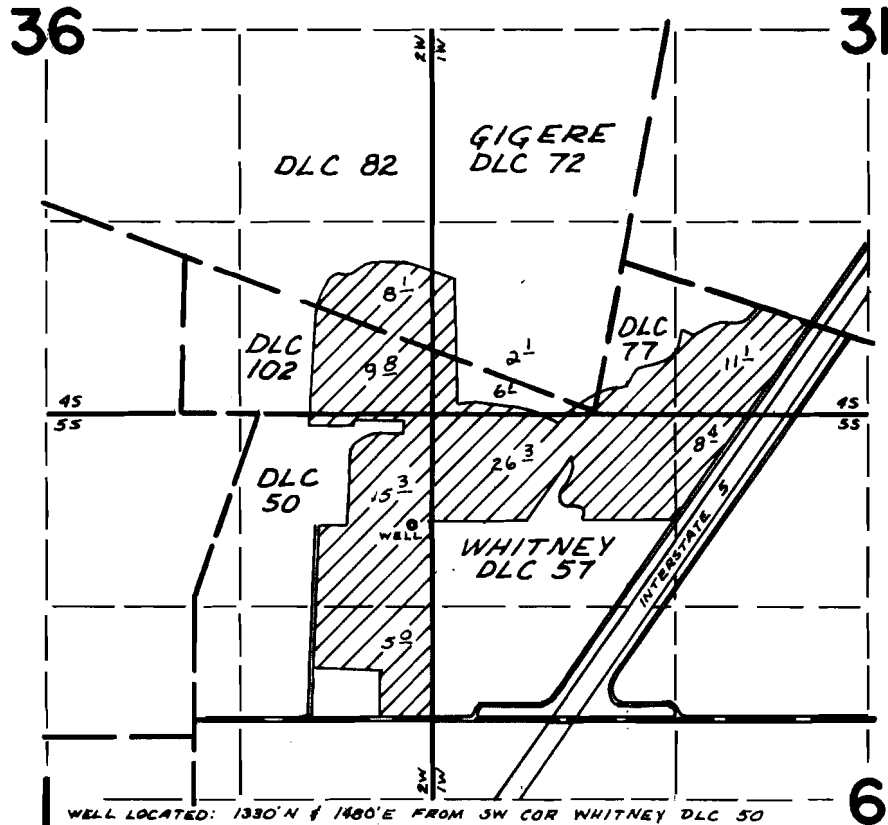

FINAL PROOF SURVEY UNDER

Application No. G-3982 Permit No. G-3739
IN NAME OF

RALPH WURDINGER

Surveyed Oct 6 1972, by D. Norby