


T.9 S.R.2W.W.M.

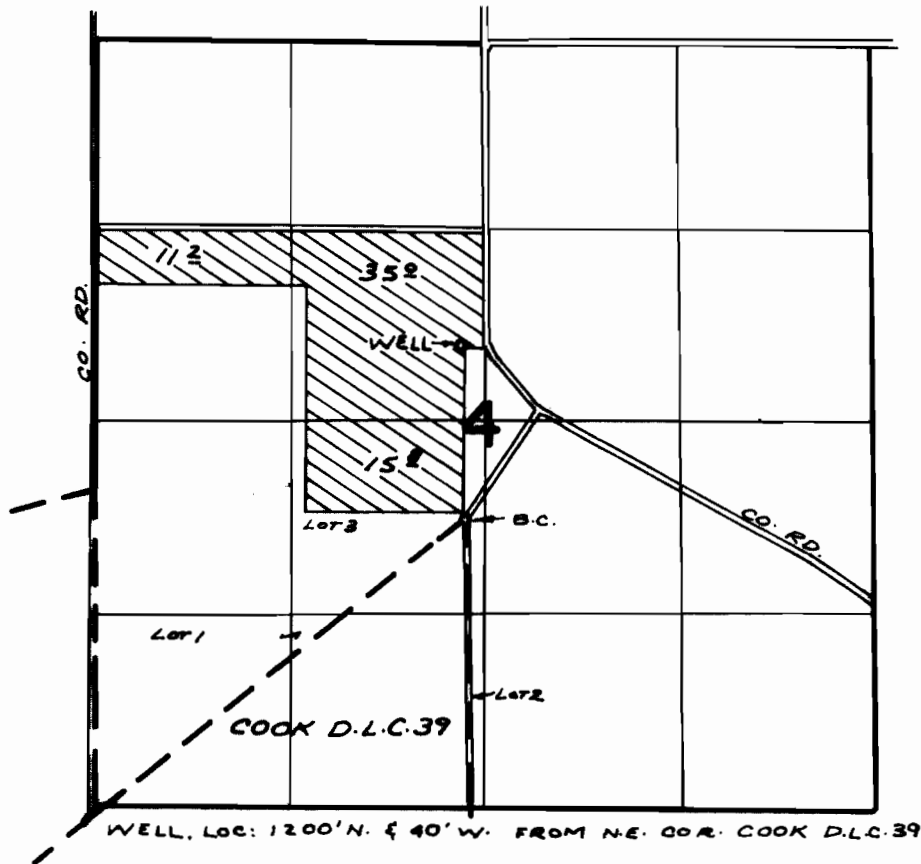

FINAL PROOF SURVEY UNDER

Application No. G-4382 Permit No. G-3825
IN NAME OF

FRANCIS E. ETZEL

Surveyed OCT. 26, 1972, by R. MUCKEN