


T.6S. R.1E & 1W. W.M.

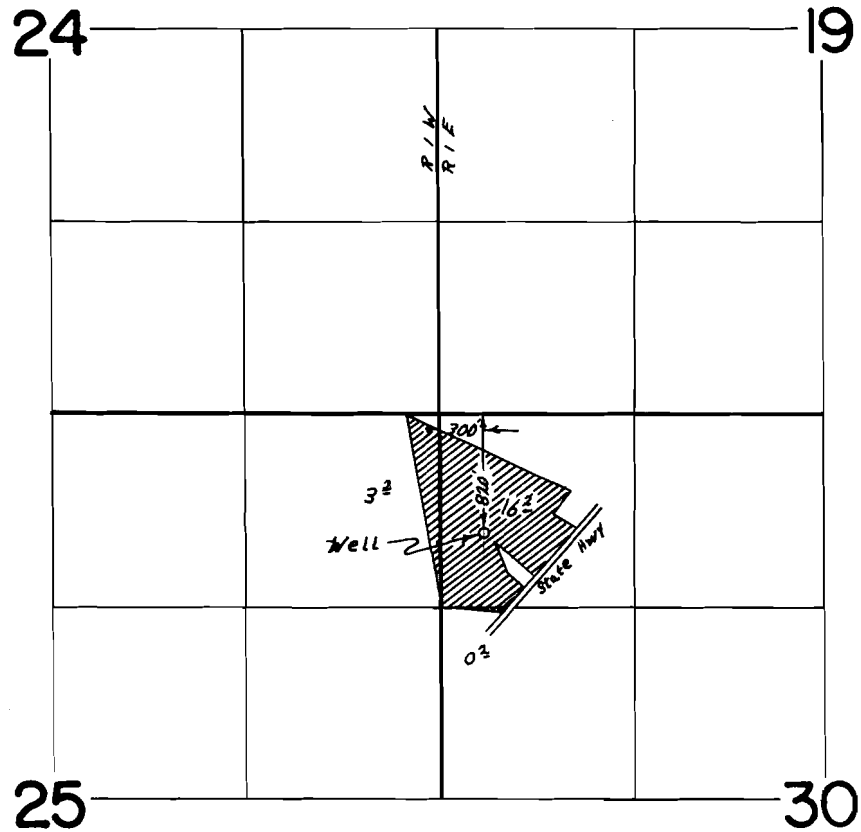

FINAL PROOF SURVEY
UNDER

Application No. G-4110 Permit No. B-3858
IN NAME OF

BERT S. & DOROTHY J. LAUDETTE

Surveyed June 15 1972, by R. G. Mucken