


T.6S. R.1&2W. W.M.

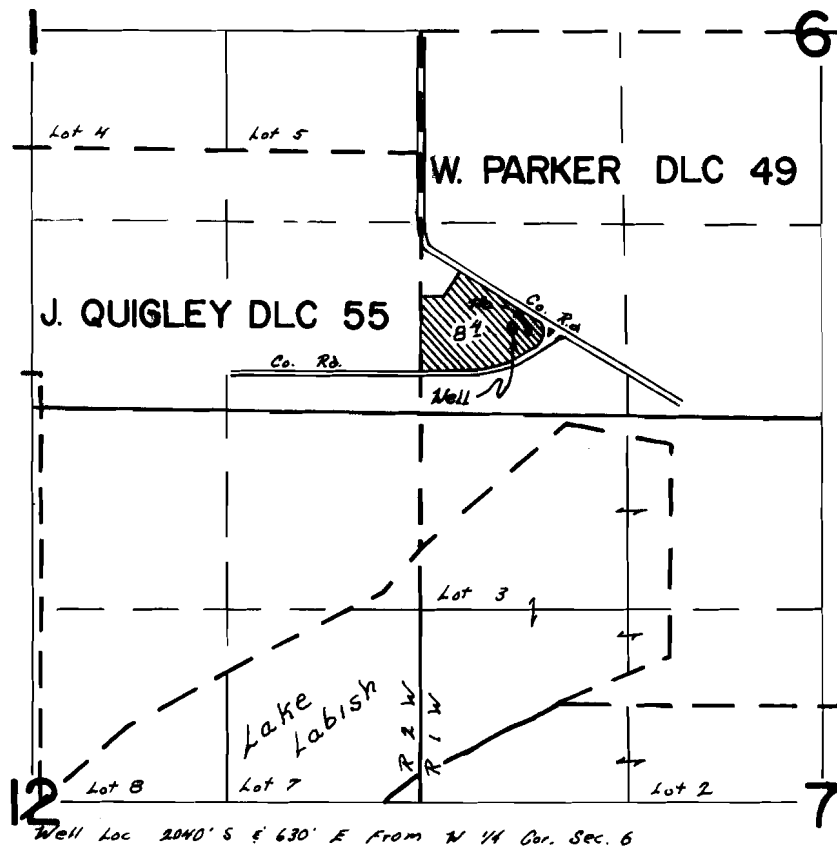

FINAL PROOF SURVEY
UNDER

Application No. G-1211 Permit No. G-3975
IN NAME OF

WILLIAM JEBOUSEK

Surveyed July 5 1972, by R. G. Muckert