T.5 S. R.1 & 2 W. W.M.

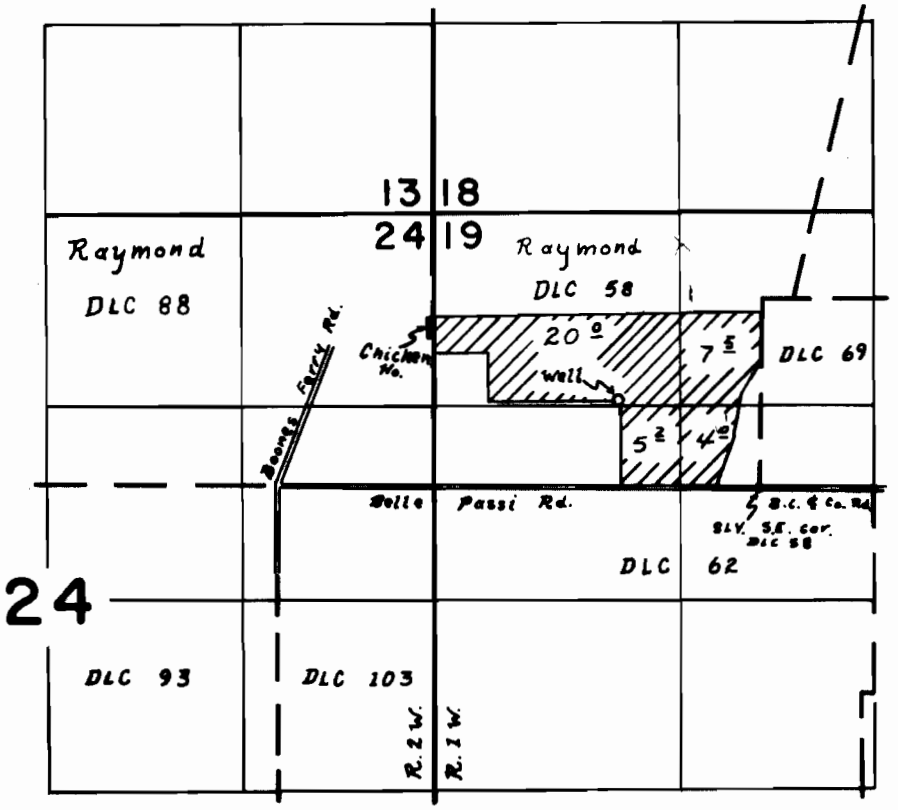

Well loc. 625' N. & 950' W. from Sly. S.E. cor. Raymond DLC 58

FINAL PROOF SURVEY
UNDER

Application No. G-4407 Permit No. G-4153
IN NAME OF

Glen E. Schwenke

Surveyed 12 OCT 1972, by D. O'Reilly

PHOTO-DEN-6LL-197