


T.5S. R.1&2W. WM.

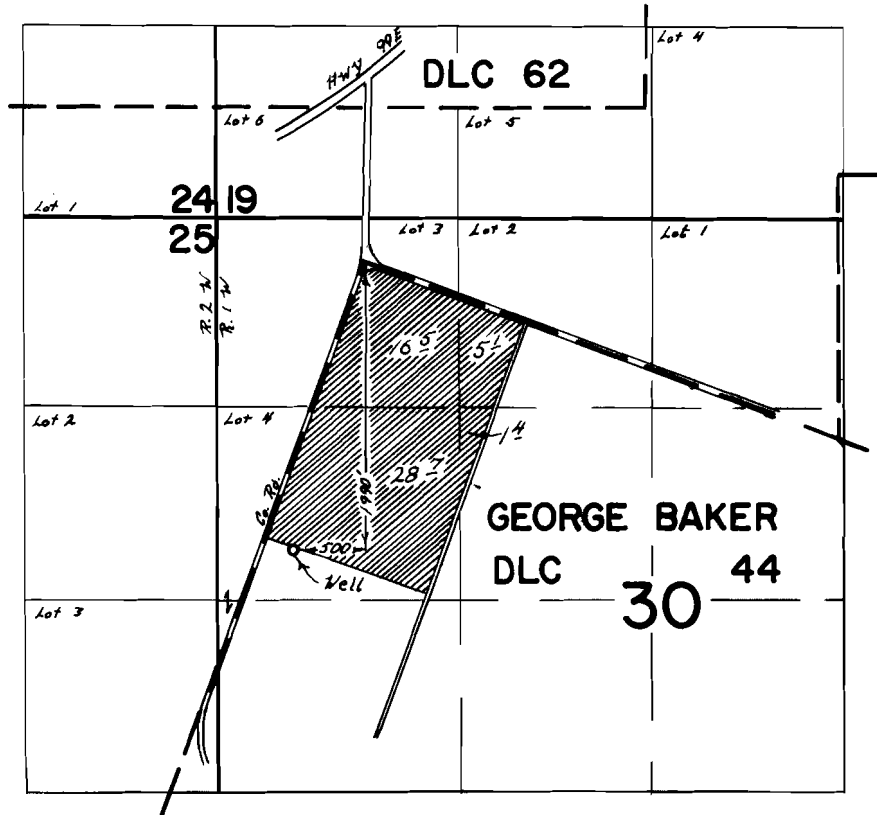

FINAL PROOF SURVEY
UNDER

Application No. G-4461 Permit No. G-4204

IN NAME OF

JOHN ESCH

Surveyed Aug. 18 1972, by R. B. Mucken