


T.5S. R.1&2W. W.M.

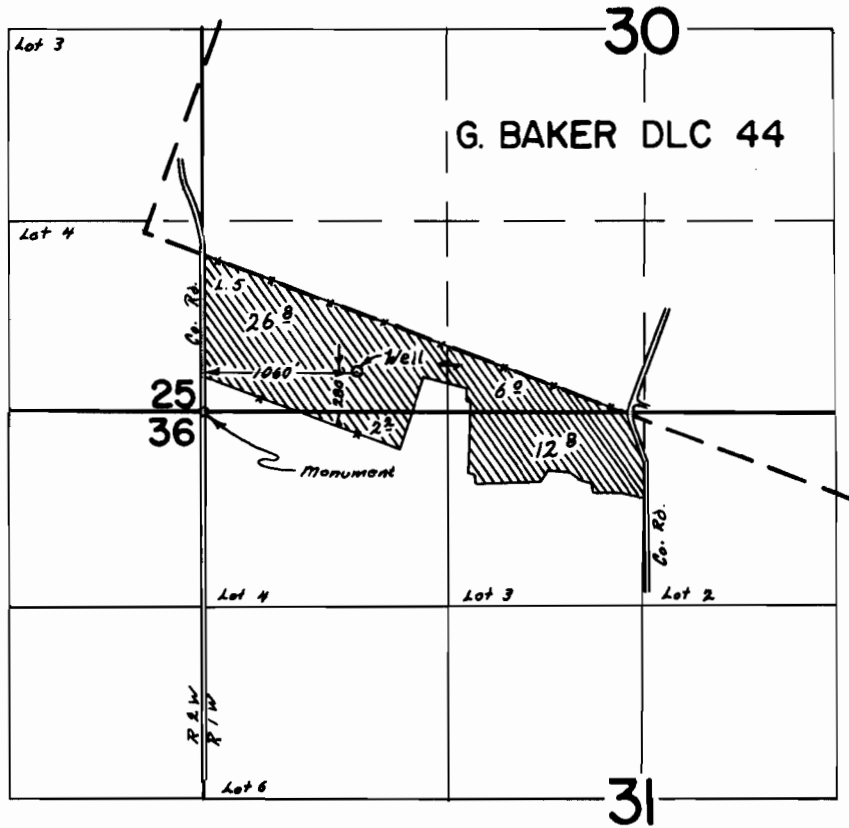

**FINAL PROOF SURVEY**  
UNDER

Application No. G-4801 Permit No. G-4526  
IN NAME OF

MARTIN VACHTER, JR.

Surveyed Aug. 18 1922, by R. G. Musken