


T.6S. R.2W. W.M.

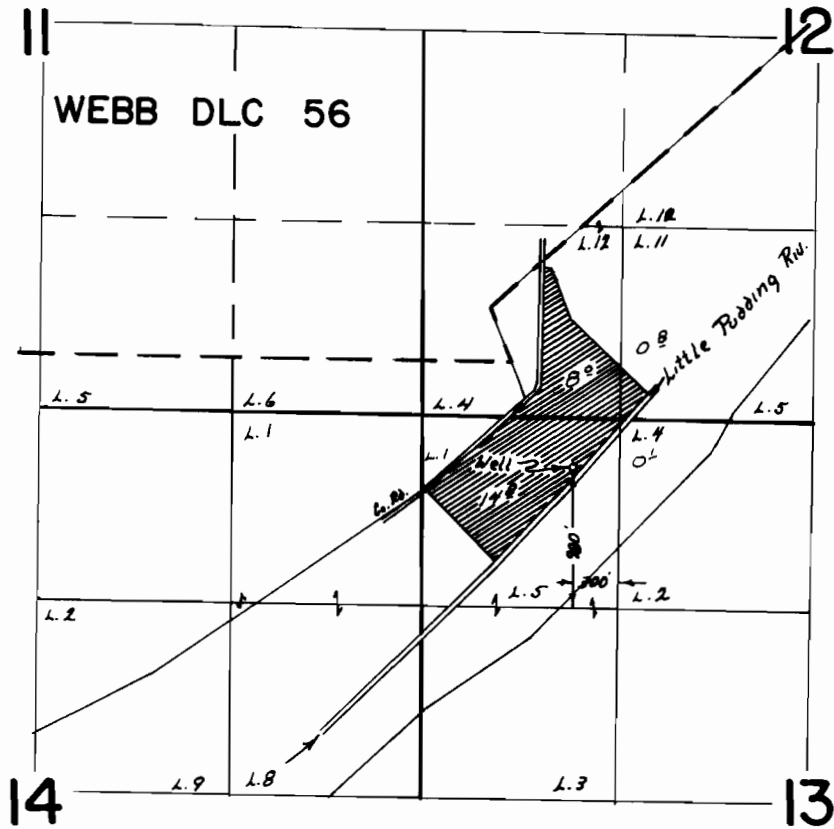

FINAL PROOF SURVEY
UNDER

Application No. G-4851 Permit No. G-4568
IN NAME OF

PETE LELACK

Surveyed May 17 1972, by R.G. Mucken