


T.5S. R.1W. W.M.

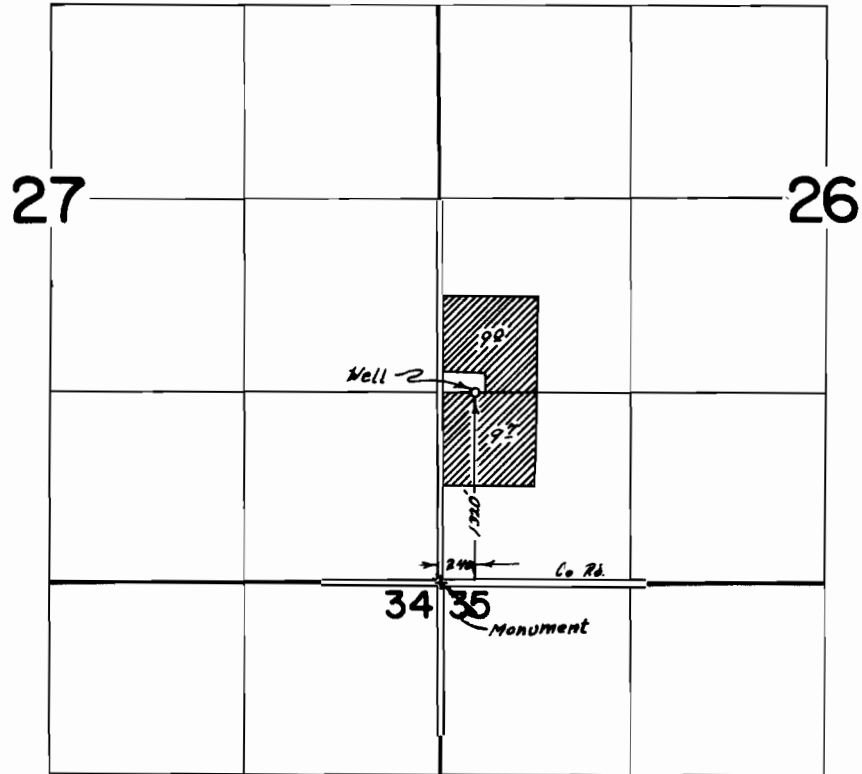

FINAL PROOF SURVEY
UNDER

Application No. B-485B Permit No. G-4574
IN NAME OF

DAVID SCHARER

Surveyed Aug 17 1972, by R. G. Mucken