


T. 7S. R. 2W. W.M.

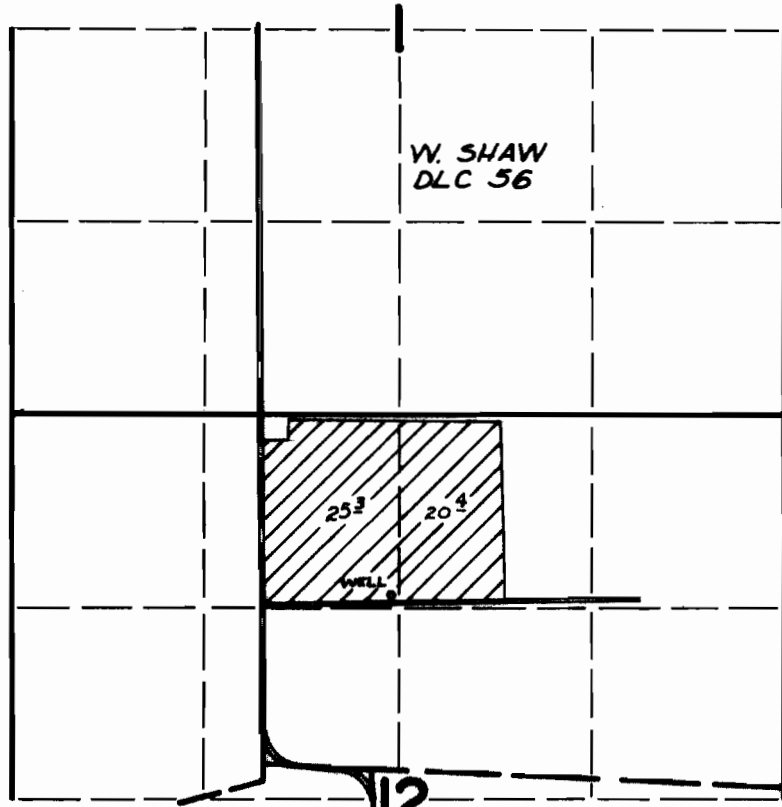

WELL LOCATED: 1150' N & 870' E FROM SW COR SHAW DLC 56

FINAL PROOF SURVEY UNDER

Application No. G-4903 Permit No. G-4621
IN NAME OF

CECIL ROTH

Surveyed APR 27 1972, by D. Norby