


T.6S. R.2W W.M.

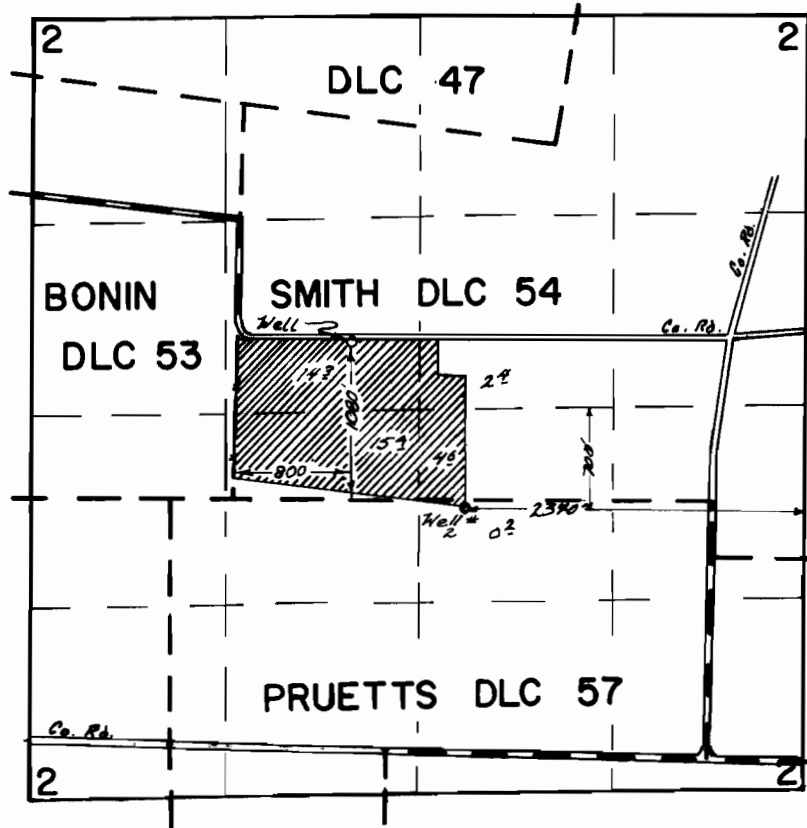

FINAL PROOF SURVEY
UNDER

Application No. G-4908 Permit No. G-4623
IN NAME OF

MRS. DONALD A. STILL

Surveyed May 18 1972, by P. A. Mucken