


T. 6 S. R. 2 W. W.M.

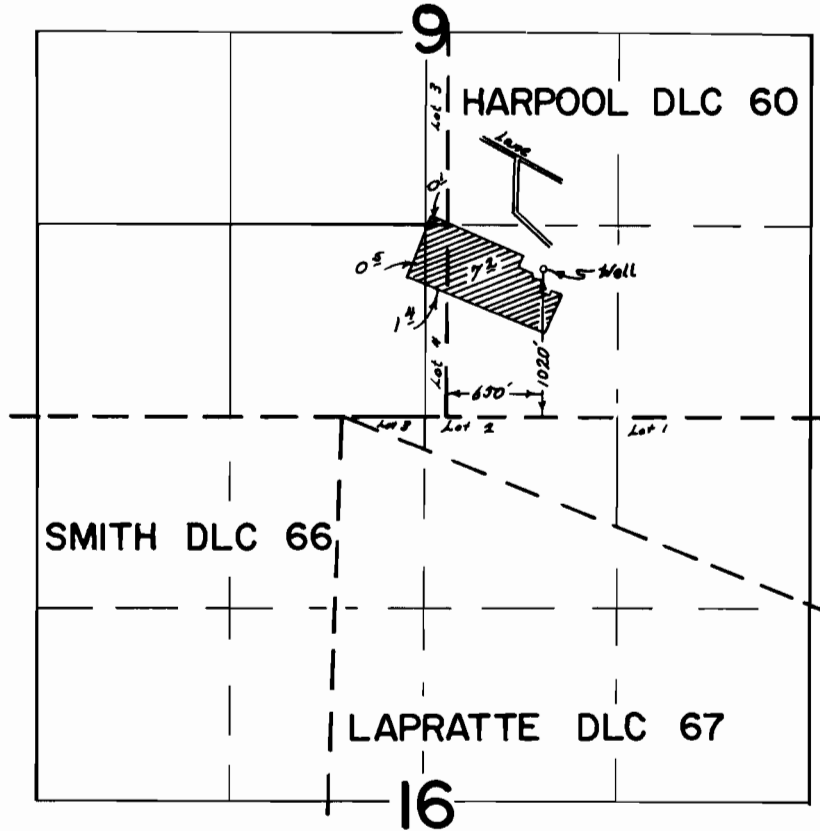

FINAL PROOF SURVEY
UNDER

Application No. G-4929 Permit No. P-4653
IN NAME OF

DONALD E. & DONNELLA M. WELLS

Surveyed May 17 1972, by R. B. Mucken