


T.6S R.2W. W.M.

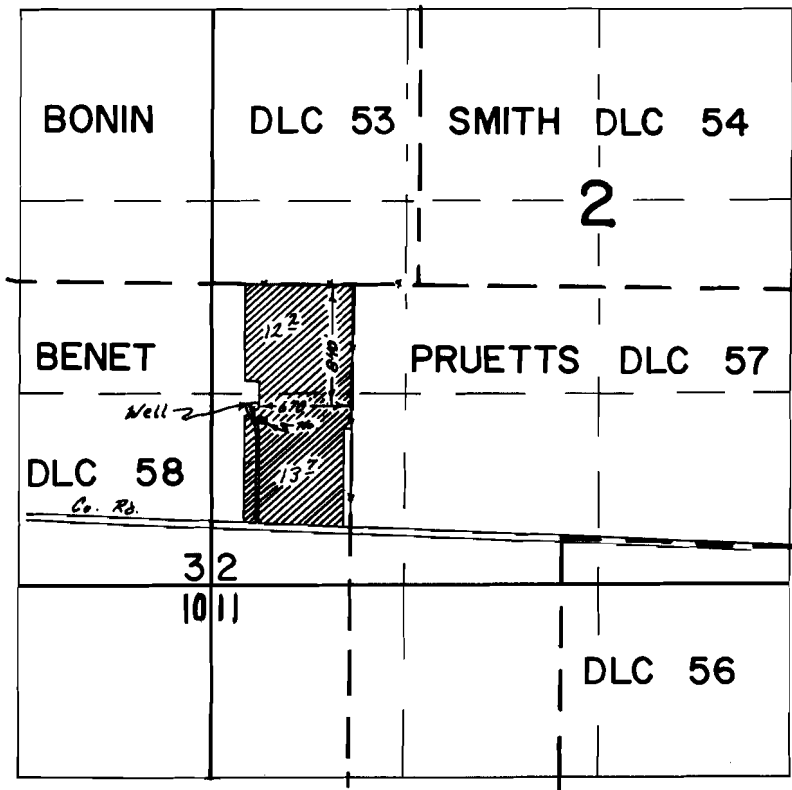

FINAL PROOF SURVEY UNDER

Application No. 6-5070 Permit No. B-4787
IN NAME OF

ROBERT P. GARDNER

Surveyed April 26 1972, by R. B. Mucken