


T. 6 S. R. 2 W. W.M.

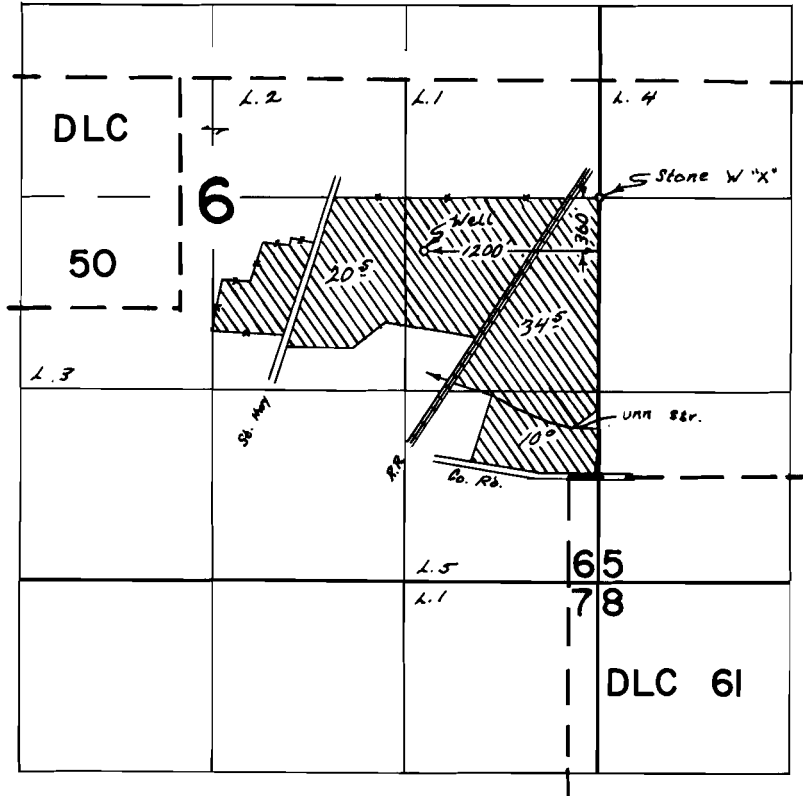

FINAL PROOF SURVEY
UNDER

Application No. E-3090 Permit No. E-4805
IN NAME OF

HOMER & DOLORES ZIELINSKI

Surveyed May 19 1972, by R. G. Mucken