


T.6S. R.1W. W.M.

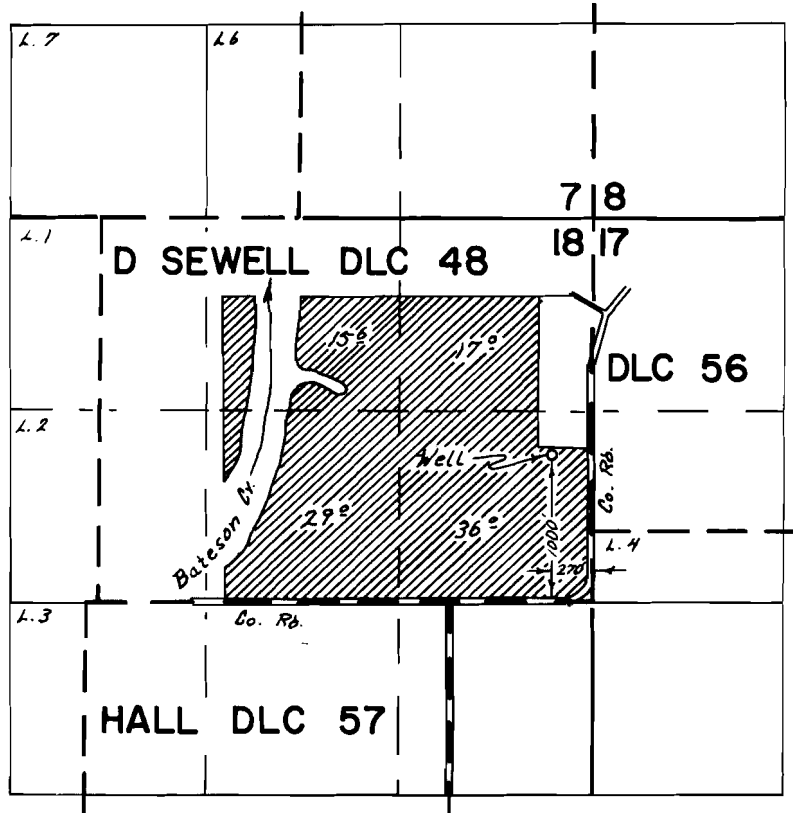

FINAL PROOF SURVEY UNDER

Application No. Q-5022 Permit No. Q-4808
IN NAME OF

ERVIN EML LITTAU

Surveyed June 12, 1972, by R. B. Mucken