


T.10S.,R.3W.,W.M.

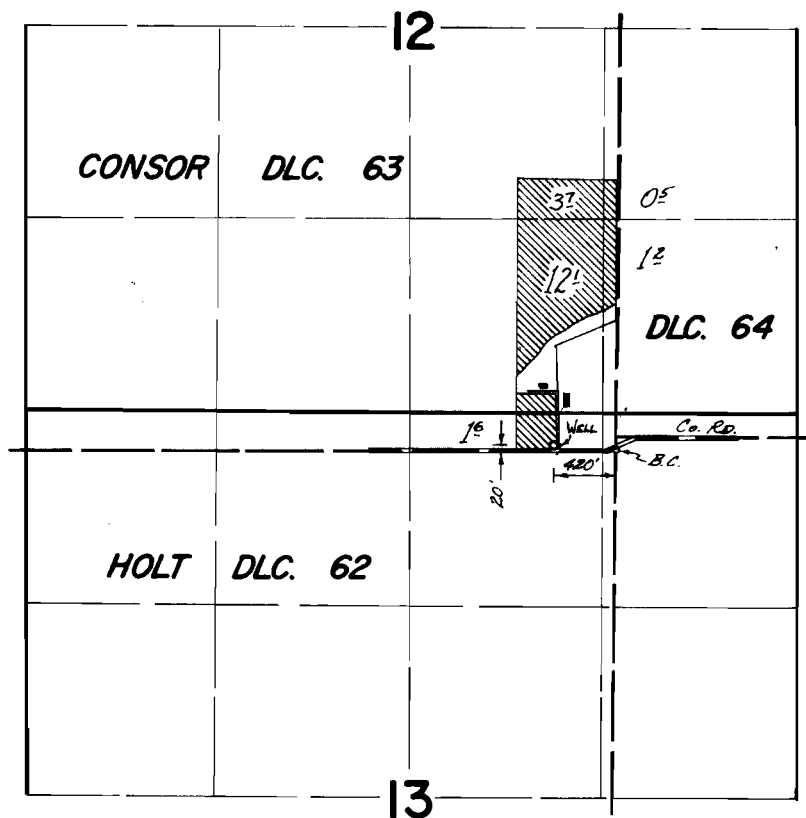

FINAL PROOF SURVEY
UNDER


Application No. G-5162 Permit No. G-4894
IN NAME OF

STAN P. DeGULIS

Surveyed Oct. 18 1972, by D. O'REILLY

T. 10 S. R. 3 W. W.M.

20' x 420'

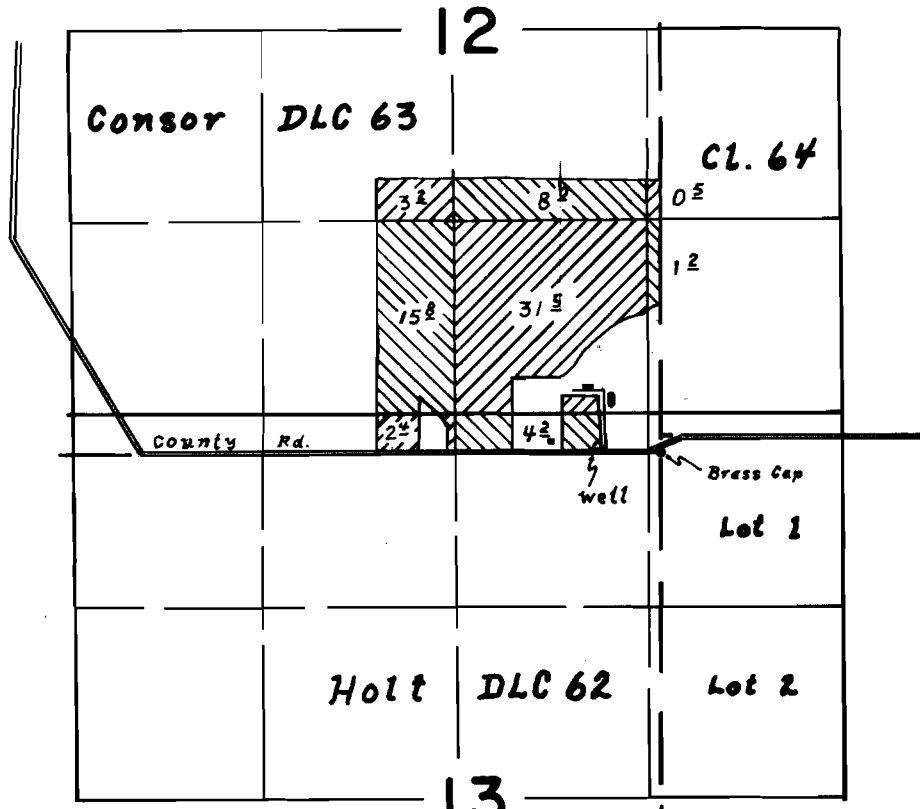

Well loc. 20' N. & 420' W. from S.E. cor. DLC 63

FINAL PROOF SURVEY
UNDER

Application No. G-5162 Permit No. G-4894
IN NAME OF

Stan P. DeGulis

Surveyed 18 OCT. 1972. by D. O'Reilly