


T. 4 S., R. 2 W., W.M.

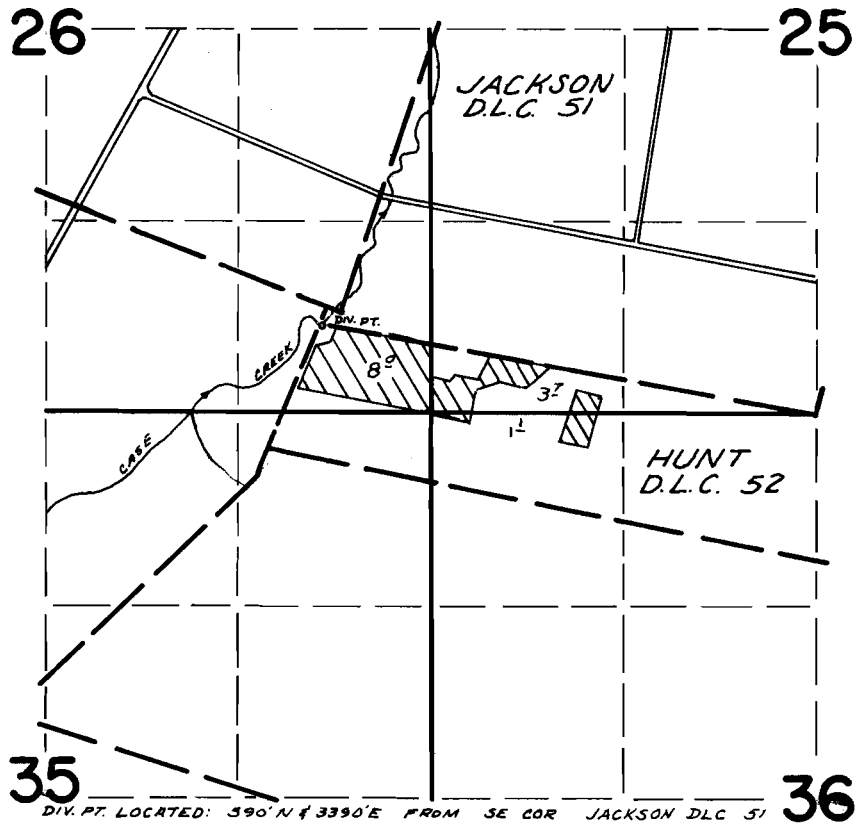

FINAL PROOF SURVEY UNDER

Application No. 43457 Permit No. 32505
IN NAME OF

JAKE R. SONNEN & SON

Surveyed Oct. 5 1972, by D. Norby