


T.6S.R.1E.W.M.

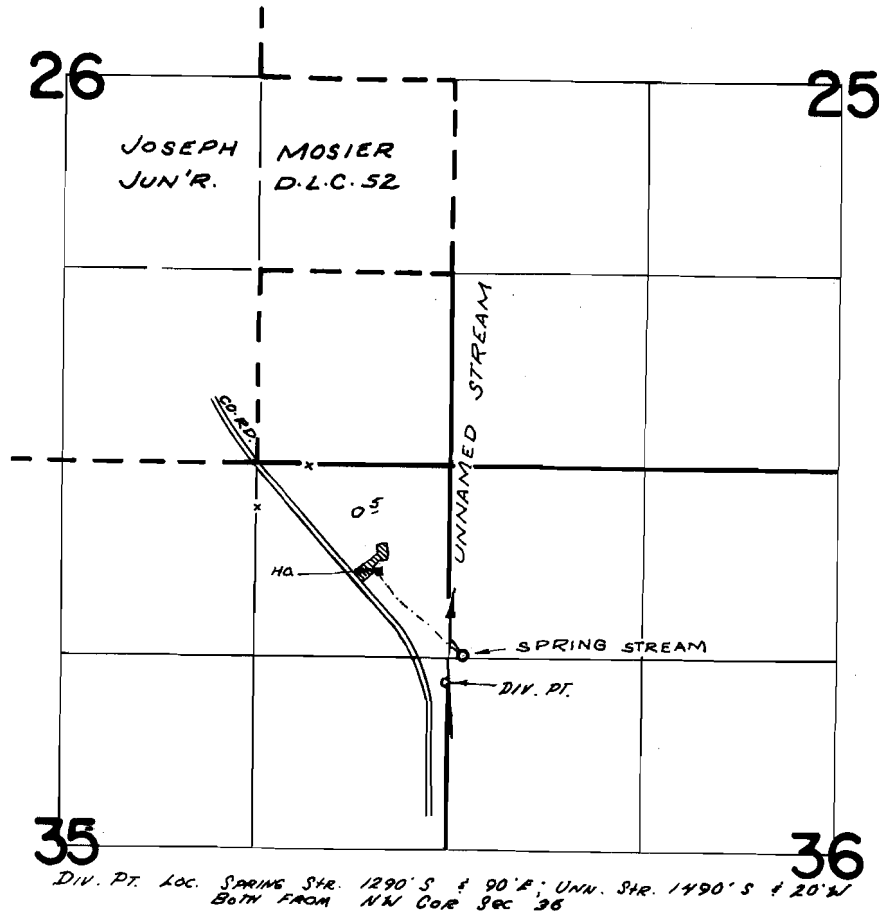

FINAL PROOF SURVEY
UNDER

TRANSFER No. C-179
Application No. 43841..... Permit No. 32769.....
IN NAME OF

...S. KENNETH & KATHERYN H. JOHNSON

Surveyed OCT. 12, 1972, by R. MUCKEN