


# T. 4 S., R. 2 W., W.M.

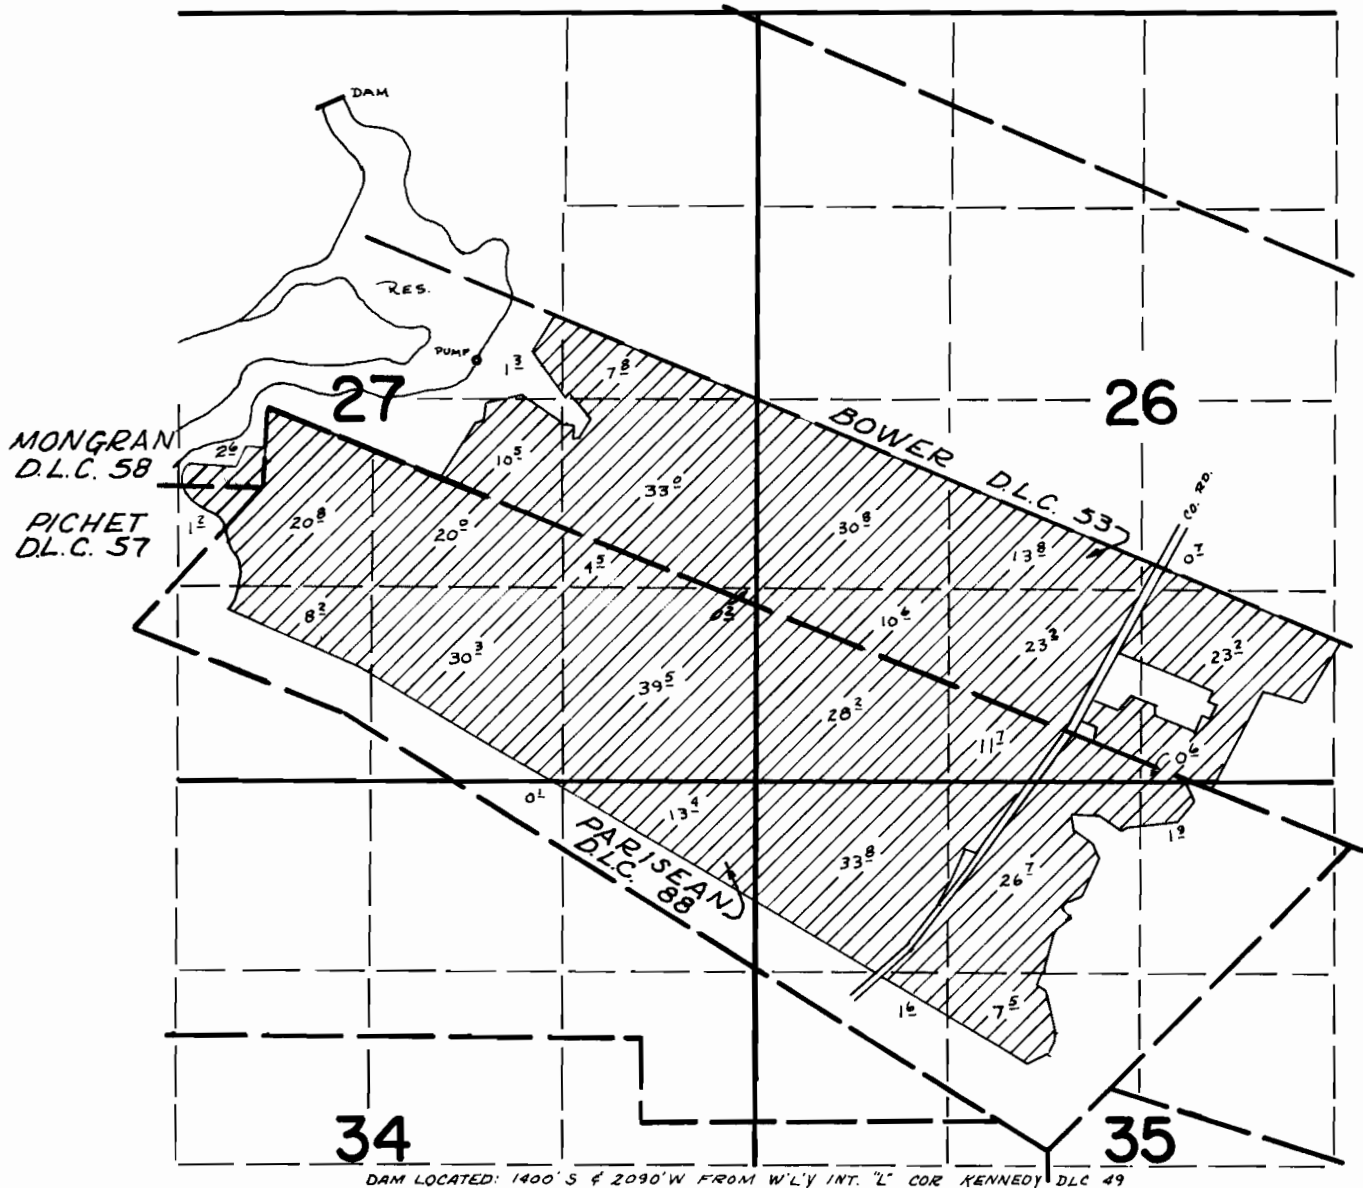

DAM LOCATED: 1400' S & 2090' W FROM W'LY INT. "L" COR KENNEDY DLC 49

## FINAL PROOF SURVEY UNDER

Application No. 44923 Permit No. 33492  
IN NAME OF

Estate of NEAL MILLER

Surveyed Oct. 2 1972, by D. Norby