


# T. 7 S. R. 1 W. W.M.

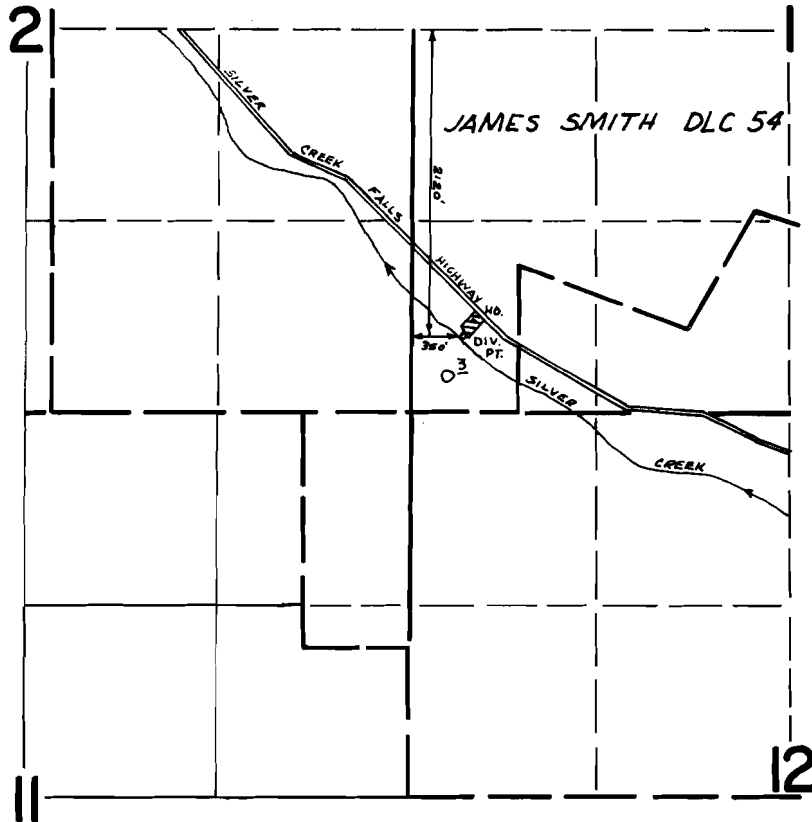

## FINAL PROOF SURVEY UNDER

Application No. 45038 Permit No. 33660  
IN NAME OF

LEE O. DYER

Surveyed APRIL 21, 1972, by D. NORBY